

COPY

LIBER 19758PG468

LAND CORNER RECORDATION CERTIFICATE
Filing Requirement of Act 74, Mich. P.A. 1970

106282

For corners in

Oakland
(County)

Located in:

Corner Code #

1. Public Land Survey

T 5N R 8E G-5

T R

T R

T R

2. Property Controlling in Section

S T R SURVEY & REMONUMENTATION

S T R

3. Miscellaneous Property in Sec.

S T R MAR 21 2000

S T R

LIBER 19758 PAGE 468
\$7.00 MISC RECORDING
\$2.00 REMONUMENTATION
03/30/1999 01:03:22 P.M. RECEIPT# 12968
PAID RECORDED - OAKLAND COUNTY
G. WILLIAM CADDELL, CLERK/REGISTER OF DEEDS

Compliance with
ACT 345, P.A. 1990


APPROVED ON: 8-27-98 JS
OAKLAND COUNTY REMONUMENTATION
PEER GROUP COMMITTEE

Register of Deeds Stamp & File Number

4. Lot No. _____, Recorded Plat _____ SECTION _____
5. Private Claims _____

I, Timothy J. Hart, in a field survey on 8-18, 1998 do hereby state that under requirements of P.A. 74, Michigan P.A. of 1970, the corner points mentioned in lines 1 and 2 above were in conformance with regulations and rules therefore as required in the current manual of survey instructions of the United States Department of the Interior, Bureau of Land Management or by a decree of a Court of Law and /or that the corner points mentioned in lines 3, 4 and 5 above were in conformance with the rules of the Michigan Board of Land Surveyors or by a Decree of a Court of Law; established, re-established, monumented, recovered, found as expressed below:

NOTE: Not more than 2 corners, all in the same town and range, may be recorded on this certificate.

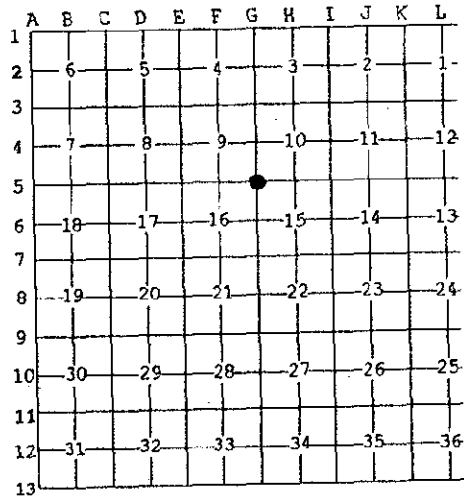

A. Description of original monument and accessories and/or subsequent restoration:

Post set in 1823 G.L.O. survey; 6" Tamarack N 89°E 7 lks; 8" Tamarack N 88°W 17 lks.
There is no record of subsequent restoration of this corner.

B. Description of corner evidence found and/or method applied in restoring or reestablishing corner:

Recovered a pinch top pipe 0.40 ft east of old corner fence post. Old farm fence remnants run north, south and west from the recovered corner. Corner is located in a wetlands area on the Camp Tamarack property, 1/4 mile south of Perryville Road.

The pinch top pipe is located N 14°22'W 7.15 ft from the corner location calculated by double proportionate measurement.

IP
R

C. Description of monument for corner and accessories established to perpetuate locating the position of the corner:

Set concrete monument with O.C. remonumentation brass cap, replacing pinch top pipe.

- N 30°W 12.62' PK/remon tag NE 10" Tamarack
- N 45°E 17.02' PK/remon tag NW 6" Elm
- S 20°E 15.41' PK/remon tag E. 8" Elm
- S 40°W 16.20' PK/remon tag E. twin 4" Cherry

State Plane Coordinates
N 491574.1216
E 13352790.4800

The selected location is accepted by the Contractor and is generally accepted by professional surveyors as the best available evidence of the position of the original corner. This corner was also accepted by the Oakland County Peer Group as established under Act 345 of P.A. 1990.

Signed by Timothy J. Hart
Surveyor's Michigan License No. 33136

Date 8-27-98