

COPY

LIBER 19758PG469

106283

LAND CORNER RECORDATION CERTIFICATE
Filing Requirement of Act 74, Mich. P.A. 1970

LIBER 19758 PAGE 469
\$7.00 MISC RECORDING
\$2.00 REMONUMENTATION
03/30/1999 01:03:22 P.M. RECEIPT# 1296
PAID RECORDED - OAKLAND COUNTY
G. WILLIAM CADDELL, CLERK/REGISTER OF D

For corners in

Oakland
(County)

Located in:

Corner Code #

1. Public Land Survey

T 5N R 8E G-6

T R
T R SURVEY &
T R RE-ESTABLISHMENT

2. Property Controlling in Section

S T R
S T R MAR 21 2000

3. Miscellaneous Property in Sec.

S T R
S T R SECTION

Compliance with
ACT 345, P.A. 1990
APPROVED ON: 8-27-98 JS
OAKLAND COUNTY REMONUMENTATION
PEER GROUP COMMITTEE
Register of Deeds Stamp & File Number

4. Lot No. _____, Recorded Plat _____
5. Private Claims _____

I, Timothy J. Hart, in a field survey on 6-5, 1998 do hereby state that under requirements of P.A. 74, Michigan P.A. of 1970, the corner points mentioned in lines 1 and 2 above were in conformance with regulations and rules therefore as required in the current manual of survey instructions of the United States Department of the Interior, Bureau of Land Management or by a decree of a Court of Law and/or that the corner points mentioned in lines 3, 4 and 5 above were in conformance with the rules of the Michigan Board of Land Surveyors or by a Decree of a Court of Law; established, re-established, monumented, recovered, found as expressed below:


	A	B	C	D	E	F	G	H	I	J	K	L
1												
2	6		5		4		3		2		1	
3												
4	7		8		9		10		11		12	
5												
6	18		17		16		15		14		13	
7												
8	19		20		21		22		23		24	
9												
10	30		29		28		27		26		25	
11												
12	31		32		33		34		35		36	
13												

NOTE: Not more than 2 corners, all in the same town and range, may be recorded on this certificate.

A. Description of original monument and accessories and/or subsequent restoration:

Post set in 1823 G.L.O. survey;
10" B. Oak N 52°W 34 lks; 12" W. Oak S 73°E 27 lks

No record of subsequent restoration of corner.

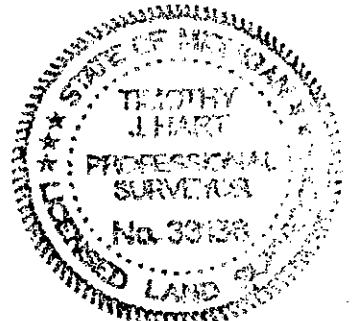

B. Description of corner evidence found and/or method applied in restoring or reestablishing corner:

The intersection of a tree/rock/fence row running west and north, a fence line running east, and a tree row running south occupies the position of the corner. The corner is located in Camp Tamarack, 1/4 mile east of Barron Road and 1/2 mile north of Grange Hall Road. The corner was set midpoint on line between the NE (G-5) and SE (G-7) corners of Section 16 at the occupied corner.

IP
R.

C. Description of monument for corner and accessories established to perpetuate locating the position of the corner:
Set concrete monument with O.C. remonumentation brass cap.

N 20°W 9.55' PK/remon tag E. 24" Oak
N 45°E 4.45' PK/remon tag NW 6" Cherry
South 15.12' PK/remon tag E. 24" Hickory
West 16.58' PK/remon tag N. 18" Oak

State Plane Coordinates
N 488944.1465
E 13352900.2560

The selected location is accepted by the Contractor and is generally accepted by professional surveyors as the best available evidence of the position of the original corner. This corner was also accepted by the Oakland County Peer Group as established under Act 345 of P.A. 1990.

Signed by Timothy J. Hart
Surveyor's Michigan License No. 33136

Date 9-2-98