

COPY

LIBER 19758 PG 479

LAND CORNER RECORDATION CERTIFICATE
Filing Requirement of Act 74, Mich. P.A. 1970

106293

For corners in Oakland (County)

Located In:

Corner Code #

- 1. Public Land Survey T 5N R 8E H-5
2. Property Controlling in Section S T R REF SURVEY & RESTORATION
3. Miscellaneous Property in Section S T R MAR 21 2000

LIBER 19758 PAGE 479
\$7.00 MISC RECORDING
\$2.00 REMONUMENTATION
03/30/1999 01:03:22 P.M. RECEIPT# 12961
PAID RECORDED - OAKLAND COUNTY
G. WILLIAM CADDELL, CLERK/REGISTER OF DEEDS

Compliance with ACT 345, P.A. 1990

APPROVED ON: 3-10-99 JS
OAKLAND COUNTY REMONUMENTATION PEER GROUP COMMITTEE

Register of Deeds Stamp & File Number

- 4. Lot No. , Recorded Plat SECTION
5. Private Claims

I, Timothy J. Hart, in a field survey on 2-15, 19 99, do hereby certify that under requirements of P.A. 74, Michigan P.A. of 1970, the corner points mentioned in lines 1 and 2 above were in conformance with regulations and rules therefore as required in the current manual of survey instructions of the United States Department of the Interior, Bureau of Land Management or by a decree of a Court of Law and/or that the corner points mentioned in lines 3, 4 and 5 above were in conformance with the rules of the Michigan Board of Professional Surveyors or by a Decree of a Court of Law; established, re-established, monumented, re-monumented, recovered, found as expressed below:

NOTE: Not more than 4 corners, all in the same town and range, may be recorded on this certificate.

A. Description of original monument and accessories and/or subsequent restoration:

Post set in 1823 G.L.O. survey; 7" W. Oak N 33°E 33 lks; 9" W. Oak S 51°E 33 lks.

No record of subsequent restoration of corner.

B. Description of corner evidence found and/or method applied in restoring or reestablishing corner:

Corner falls in Phillips Lake within the Camp Tamarack property. A farm fence with large trees runs north from the north shore of the lake, approximately on the N-S 1/4 line. The final location of the parcel was calculated midpoint on line between corners G-5 and I-5. A reference point was calculated and set on the south section line, located 40.00 ft east of corner H-5, approximately 16 ft from the water's edge of Phillips Lake.


C. Description of monument for corner and accessories established to perpetuate locating the position of the corner:

Set concrete monument with O.C. remonumentation brass cap at reference point on section line located 40.00 ft east of corner H-5.
N 10°E 37.90' PK/remon tag E. 18" Oak
N 40°E 10.00' PK/remon tag S. 22" Oak
S 85°E 30.12' PK/remon tag S. 12" Oak
S 10°W 9.30' PK/remon tag E. 24" Oak
State Plane Coordinates of H-5
N 491692.0590
E 13355413.9476

The selected location is accepted by the Contractor and is generally accepted by professional surveyors as the best available evidence of the position of the original corner. This corner was also accepted by the Oakland County Peer Group as established under Act 345 of P.A. 1990.

Signed by Timothy J. Hart
Surveyor's Michigan License No. 33136

Date 3-5-99

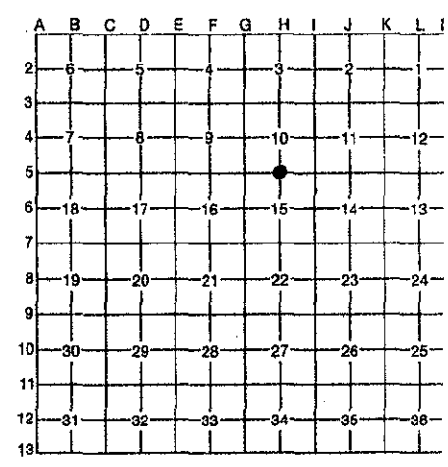

lp
R