

SURVEY & REMONUMENTATION

LIBER **14960** PC **091**

MAY - 1 1995

94 **242421**

LAND CORNER RECORDATION CERTIFICATE
Filing Requirement of Act 74, Mich. P.A. 1970

OK - T. SMITH

For corners in **COMMISSION**
Oakland
(County)

Located in: Brandon Township Corner Code #


- | | | |
|------------------------------------|---------------------------|-------|
| 1. Public Land Survey | T <u>5</u> N R <u>9</u> E | I-3 |
| | T _____ R _____ | _____ |
| | T _____ R _____ | _____ |
| | T _____ R _____ | _____ |
| 2. Property Controlling in Section | S _____ T _____ R _____ | _____ |
| | S _____ T _____ R _____ | _____ |
| 3. Miscellaneous Property in Sec. | S _____ T _____ R _____ | _____ |
| | S _____ T _____ R _____ | _____ |

\$ 7.00 MISCELLANEOUS RECORDING
\$ 2.00 REMONUMENTATION
8 SEP 94 3:16 P.M. RECEIPT# 134B
PAID RECORDED - OAKLAND COUNTY
LYNN D. ALLEN, CLERK/REGISTER OF DEEDS

Compliance with ACT 345, P.A. 1990

APPROVED ON: 12-29-93
OAKLAND COUNTY REMONUMENTATION
Register of Deeds Stamp File Number

4. Lot No. _____, Recorded Plat _____
5. Private Claims _____

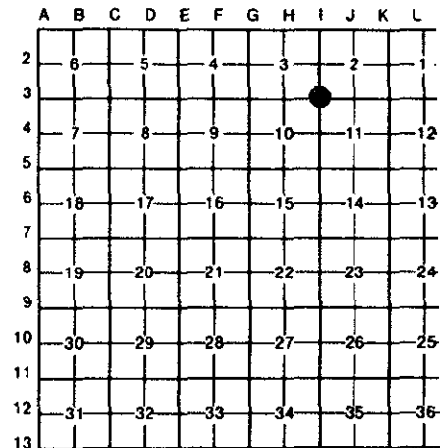

I, Huston K. Kennedy, in a field survey on October 27, 1993, do hereby certify that under requirements of P.A. 74, Michigan P.A. of 1970, the corner points mentioned in lines 1 and 2 above were in conformance with regulations and rules therefore as required in the current manual of survey instructions of the United States Department of the Interior, Bureau of Land Management or by a decree of a Court of Law and/or that the corner points mentioned in lines 3, 4 and 5 above were in conformance with the rules of the Michigan Board of Land Surveyors or by a Decree of a Court of Law; established, re-established, monumented, re-monumented, recovered, found as expressed below:

NOTE: Not more than 4 corners, all in the same town and range, may be recorded on this certificate.

A. Description of original monument and accessories and/or subsequent restoration:

- 1817 GLO - Wampler, D.S.; Post set; 16" Black Oak S48°W 8 lks; 16" White Oak S28°E 21 lks
- 1972 Heil, P.S. #18993; LCRC L.5878, Pg.646-647 - Fnd 1/2" iron rod
- 1973 Jones, P.S. #16045; LCRC L.6059, Pg.688-689 - Fnd 1/2" iron rod
- 1974 Kennedy, P.S. #17623; LCRC L.6239, Pg.655-656 - Fnd 1/2" iron rod
- 1974 Buckerfield, P.S. #10868; LCRC L.6260, Pg.666-667, - Fnd 1/2" iron rod
- 1976 Pangus, P.S. #21578; Survey L.6691, Pg.53; Survey L.6620, Pg.331-333 - Fnd 1/2" iron rod
- 1976 Albright, P.S. #10057; LCRC L.6813, Pg.491-492 - Fnd 1/2" iron rod
- 1979 Smith, P.S. #21582; LCRC L.7656, Pg.603-605, - Same wits as 1972 LCRC
- 1992 Kennedy, P.S. #17623; LCRC L.12730, Pg.864 - Fnd 1/2" iron rod

B. Description of corner evidence found and/or method applied in restoring or reestablishing corner:

1993 Kennedy Surveying, Inc. - Kennedy, P.S. #17623 - Fnd 1/2" iron rod 1'+ South of the centerline of Oakwood Road which is bituminous surface, and at the center of Connell Road which is gravel.
The witnesses in the power poles are still existing. They were used to recover and verify the found 1/2" iron rod.

I accepted the found 1/2" iron rod as the best evidence of the original corner position.

C. Description of monument for corner and accessories established to perpetuate locating the position of the corner:

I-3 I replaced the found 1/2" iron rod with a 5/8" x 24" iron rod with a 2" diameter cap stamped Oakland County Remonumentation P.S. #17623 in a monument box.

- N26°W-75.19 ft-Set PK & Remon. Washer East face Power Pole
- N23°E-97.30 ft-Set PK & Remon. Washer East face Power Pole
- N76°E-128.27 ft-Set PK & Remon. Washer South face Twin Box Elder
- S06°W-47.26 ft-Set PK & Remon. Washer West face Power Pole

The selected location is accepted by me and is generally accepted by Professionals as the best available evidence of the position of the original position.

Signed by H.K. Kennedy
Surveyor's Michigan License No. 17623

Date June 20, 1994

