

MAY - 1 1995 COMMISSION

LIBER 15175 PG 144

Compliance with ACT 345, P.A. 1990

LAND CORNER RECORDATION CERTIFICATE Filing Requirement of Act 74, Mich. P.A. 1970 APPROVED ON: 12-14-94 OAKLAND COUNTY REMONUMENTATION PEER GROUP COMMITTEE

Table with columns: For corners in Oakland (County), Located In: Brandon Twp., Corner Code #, and survey details (1. Public Land Survey, 2. Property Controlling in Section, 3. Miscellaneous Property in Sec.)

\$ 7.00 MISCELLANEOUS RECORDING \$ 2.00 REMONUMENTATION 29 DEC 94 9:47 A.M. RECEIPT# 46B PAID RECORDED - OAKLAND COUNTY LYNN D. ALLEN, CLERK/REGISTER OF DEEDS

OK - T. SMITH

Register of Deeds Stamp & File Number

4. Lot No. , Recorded Plat Private Claims

Grid table with columns A-L and rows 2-13, containing numbers 6 through 36.

I, Huston K. Kennedy, in a field survey on December 1, 1994, do hereby certify that under requirements of P.A. 74, Michigan P.A. of 1970, the corner points mentioned in lines 1 and 2 above were in conformance with regulations and rules therefore as required in the current manual of survey instructions of the United States Department of the Interior, Bureau of Land Management or by a decree of a Court of Law and/or that the corner points mentioned in lines 3, 4 and 5 above were in conformance with the rules of the Michigan Board of Land Surveyors or by a Decree of a Court of Law; established, re-established, monumented, re-monumented, recovered, found as expressed below:

NOTE: Not more than 4 corners, all in the same town and range, may be recorded on this certificate.

A. Description of original monument and accessories and/or subsequent restoration:

- 1817-GLO Carpenter, D.S.; Set Post 10" Aspen N57°W 55 Links
1.) 1975-Kennedy, P.S. #17623; LCRC L.6517, Pg.325 - Fnd P.K. Nail
2.) 1984-Kennedy, P.S. #17623; LCRC L.8789, Pg.453 - Fnd P.K. Nail, used same wit as 1975 LCRC
3.) 1975-Kennedy, P.S. #17623; Survey L.6506, Pg.630 - Fnd P.K. Nail used same wit as 1975 LCRC
4.) 1977-Pangus, P.S. #21578; Unrecorded Survey - Fnd P.K. Nail, used same wit as 1975 LCRC
5.) 1977-Pangus, P.S. #21578; Unrecorded Survey - Fnd P.K. Nail
6.) 1981-Kennedy, P.S. #17623; Unrecorded Survey - Fnd P.K. Nail
7.) 1985-Kennedy, P.S. #17623; Unrecorded Survey - Fnd P.K. Nail, used same wit as 1975 LCRC
8.) 1986-Kennedy, P.S. #17623; Unrecorded Survey - Fnd P.K. Nail, used same wit as 1975 LCRC
9.) 1987-Kennedy, P.S. #17623; Unrecorded Survey - Fnd P.K. Nail, used same wit as 1975 LCRC

B. Description of corner evidence found and/or method applied in restoring or reestablishing corner:

1994 Kennedy Surveying, Inc. - Kennedy, P.S. #17623 - Fnd P.K. Nail in the centerline of Baldwin Road, which has a bituminous surface and Hummer Lake Road extending to the West, which has a gravel surface. A-5 for T5N, R10E, is located 312 links (205.92 Ft.) GL Notes, but 153.05 feet measured to the North.

Witnesses from LCRC #1 and Unrecorded Survey #8 were used to recover and verify the location of the found P.K. Nail.

I accept the found P.K. Nail as the best evidence of the original corner position.

FIELD MEASUREMENTS BETWEEN

- M-5 to A-5 (Oxford Twp.) 153.09 Ft. (H. Kennedy 1987)
M-5 to L-5 2629.56 Ft. (H. Kennedy 1988)
M-5 to M-6 2643.82 Ft. (P. Pangus 1977)
M-5 to M-6 2643.23 Ft. (H. Kennedy 1994)


C. Description of monument for corner and accessories established to perpetuate locating the position of the corner:

M-5 I replaced the found P.K. Nail with a 5/8" x 24" Iron Rod w/2" diameter brass cap stamped Oakland County, Michigan, PS #17623.
S47°E 47.45' Set PK & Remon. Washer SW face 54" Oak
N31°E 112.10' Set PK & Remon. Washer NW face Power Pole
N44°W 72.73' Set PK & Remon. Washer SW face Power Pole
S82°W 94.12' Set PK & Remon. Washer North face 33" Oak

The selected location is accepted by me and is generally accepted by Professional Surveyors as the position of the original corner.

Signed by [Signature] Surveyor's Michigan License No. 17623

Date December 14, 1994

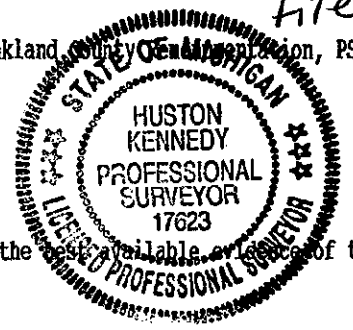

700 200 File