

LAND CORNER RECORDATION CERTIFICATE

Filing Requirement of Act 74, Mich. P.A. 1970

APPROVED ON: 8-31-94 OAKLAND COUNTY REMONUMENTATION PEER GROUP COMMITTEE

For corners in

Oakland (County)

Located In: Oxford Twp.

Corner Code #

- 1. Public Land Survey T 5N R 10E A-3
2. Property Controlling in Section S T R
3. Miscellaneous Property in Sec. S T R

\$ 7.00 MISCELLANEOUS RECORDING \$ 2.00 REMONUMENTATION 24 OCT 94 8:48 A.M. RECEIPT# 338 PAID RECORDED - OAKLAND COUNTY LYNN D. ALLEN, CLERK/REGISTER OF DEEDS

OK - T. SMITH

Register of Deeds Stamp & File Number

- 4. Lot No. Recorded Plat
5. Private Claims

I, Huston K. Kennedy, in a field survey on August 1, 1994, do hereby certify that under requirements of P.A. 74, Michigan P.A. of 1970, the corner points mentioned in lines 1 and 2 above were in conformance with regulations and rules therefore as required in the current manual of survey instructions of the United States Department of the Interior, Bureau of Land Management or by a decree of a Court of Law and/or that the corner points mentioned in lines 3, 4 and 5 above were in conformance with the rules of the Michigan Board of Land Surveyors or by a Decree of a Court of Law; established, re-established, monumented, re-monumented, recovered, found as expressed below.

NOTE: Not more than 4 corners, all in the same town and range, may be recorded on this certificate.

A. Description of original monument and accessories and/or subsequent restoration:

- 1818-GLO Wampler, D.S.; Set Post 14" White Oak S62°W 61 Links; 12" White Oak N74°W 72 Links
1.) 1974-Buckerfield, P.S. #10868; LCRC L.6260, Pg.654 - Fnd 1/2" Iron Rod
2.) 1974-Kennedy, P.S. #17623; LCRC L.6383, Pg.881 - Fnd 1/2" Iron in a Monument Box
3.) 1988-Kennedy, P.S. #17623; LCRC L.10709, Pg.793 - Fnd 1/2" Iron Rod in a Monument Box
4.) 1989-Kennedy, P.S. #17623; LCRC L.10869, Pg.250 - Fnd 1/2" Iron Rod in a Monument Box
5.) 1975-Elrich, P.S. #18986; Survey L.6432, Pg.367 - Fnd 1/2" Iron Rod in a Monument Box
6.) 1992-Kennedy, P.S. #17623; Survey L.12467, Pg.735 - Fnd 1/2" Iron Rod in a Monument Box
7.) 1988-Kennedy, P.S. #17623; Unrecorded Survey - Fnd 1/2" Iron Rod in a Monument Box

B. Description of corner evidence found and/or method applied in restoring or reestablishing corner:

1994 Kennedy Surveying, Inc. - Kennedy, P.S. #17623 - Fnd 1/2" Iron Rod in a Monument Box that is located in the centerline of Baldwin Road which is bituminous surface to the South and gravel to the North and the centerline of Oakwood Road which is bituminous surface to the East and West. The Southwest corner of Section 6 is the point of beginning of "SUPERVISOR'S PLAT NO. 1" recorded in Liber 53 of Plats, on page 16 of Oakland County Records.

Witnesses from LCRC #1 were used to recover and verify the location of the found 1/2" Iron Rod in a Monument Box.

I accepted the found 1/2" Iron Rod in a Monument Box as the best evidence of the original corner position.


C. Description of monument for corner and accessories established to perpetuate locating the position of the corner:

- A-3 I replaced the found 1/2" Iron Rod with a 5/8" x 24" Iron Rod w/2" diameter brass cap stamped Oakland County Remonumentation P. #17623 in a existing Monument Box.
N33°W 95.75' Set PK & Remon. Washer SW face Power Pole
S47°W 45.51' Set PK & Remon. Washer NW face Power Pole
S46°E 46.00' NW corner of building (Oakwood Market)
S61°E 90.65' NE corner of building (Oakwood Market)

The selected location is accepted by me and is generally accepted by Professional Surveyors as the best available evidence of the position of the original corner.

Signed by [Signature] Surveyor's Michigan License No. 17623

Date September 1, 1994

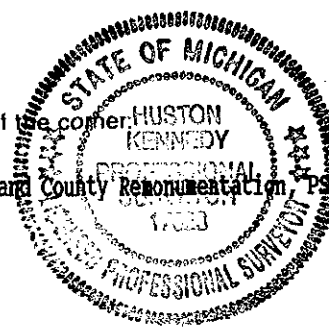

7.00 hr 2.00 file