

LIBER 15212 PG 875

JAN 20 95 01 11 89

OK - T. SMITH

LAND CORNER RECORDATION CERTIFICATE 7.00 MISCELLANEOUS RECORDING  
Filing Requirement of Act 74, Mich. P.A. 1970 2.00 REMONUMENTATION

For corners in  
Oakland  
(County)

Located In: Oxford Twp. Corner Code #

20 JAN 95 7:34 A.M. RECEIPT# 88  
PAID RECORDED - OAKLAND COUNTY  
LYNN D. ALLEN, CLERK/REGISTER OF DEEDS

1. Public Land Survey	T	5N	R	10E	A-9
	T		R		
	T		R		
	T		R		
2. Property Controlling in Section	S		T	R	
	S		T	R	
3. Miscellaneous Property in Sec.	S		T	R	
	S		T	R	

Compliance with  
ACT 345, P.A. 1990  
APPROVED ON: 12-14-94  
OAKLAND COUNTY REMONUMENTATION  
PEER GROUP COMMITTEE

Register of Deeds Stamp & File Number

- 4. Lot No. \_\_\_\_\_, Recorded Plat \_\_\_\_\_
- 5. Private Claims \_\_\_\_\_

I, Huston K. Kennedy, in a field survey on December 12, 1994, do hereby certify that under requirements of P.A. 74, Michigan P.A. of 1970, the corner points mentioned in lines 1 and 2 above were in conformance with regulations and rules therefore as required in the current manual of survey instructions of the United States Department of the Interior, Bureau of Land Management or by a decree of a Court of Law and/or that the corner points mentioned in lines 3, 4 and 5 above were in conformance with the rules of the Michigan Board of Land Surveyors or by a Decree of a Court of Law; established, re-established, monumented, re-monumented, recovered, found as expressed below:

**NOTE: Not more than 4 corners, all in the same town and range, may be recorded on this certificate.**

A. Description of original monument and accessories and/or subsequent restoration:

1817-GLO Wampler, D.S.; Set Post 14" White Oak N71°E 46 Links; 14" White Oak S40°W 65 Links

- 1.) 1974-Jones, P.S. #16045; L.6381, Pg.656 - Fnd P.K. Nail
- 2.) 1979-Lippincott, P.S. #25855; L.7447, Pg.198 - Fnd P.K. Nail
- 3.) 1982-Kennedy, P.S. #17623; L.8273, Pg.792 - Fnd 1/2" Iron Rod
- 4.) 1980-Kennedy, P.S. #17623; Unrecorded Survey - Fnd 1/2" Iron Rod, used same as 1982 LCRC
- 5.) 1981-Kennedy, P.S. #17623; Unrecorded Survey - Fnd 1/2" Iron Rod, used same as 1982 LCRC

B. Description of corner evidence found and/or method applied in restoring or reestablishing corner:

1994 Kennedy Surveying, Inc. - Kennedy, P.S. #17623 - Fnd 1/2" Iron Rod 4' East of the centerline of Baldwin Road, which has a bituminous surface, in the centerline of Seymour Lake Road extending to the East, which has a bituminous surface.

Witnesses from LCRC #1, 2 & 3 were used to recover and verify the location of the found 1/2" Iron Rod.

I accepted the found 1/2" Iron Rod as the best evidence of the original corner position.

FIELD MEASUREMENTS BETWEEN

- A-9 to M-9 (Brandon Twp.) 549.82 Ft. (H. Kennedy 1984)
- A-9 to B-9 1949.28 Ft. (H. Kennedy 1980)
- A-9 to M-10 (Brandon Twp.) 2114.12 Ft. (H. Kennedy 1979)

C. Description of monument for corner and accessories established to perpetuate locating the position of the corner:


A-9 I replaced the found 1/2" Iron Rod with 5/8" x 24" Iron Rod w/2" diameter brass cap stamped Oakland County Remonumentation, #17623 in a new Monument Box.

- S32°E 79.27' Set PK & Remon. Washer SW face Power Pole
- S66°W 65.72' Set PK & Remon. Washer North face 29" Maple
- N51°W 44.34' Set PK & Remon. Washer SW face 31" Maple
- N30°W 65.23' Set PK & Remon. Washer NE face 28" Maple

The selected location is accepted by me and is generally accepted by Professional Surveyors as the best available evidence of the position of the original corner.

Signed by [Signature]  
Surveyor's Michigan License No. 17623

Date December 16, 1994

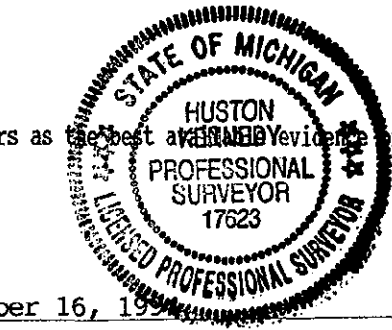

A	B	C	D	E	F	G	H	I	J	K	L
2	6	5	4	3	2	1					
3											
4	7	8	9	10	11	12					
5											
6	18	17	16	15	14	13					
7											
8	19	20	21	22	23	24					
9											
10	30	29	28	27	26	25					
11											
12	31	32	33	34	35	36					
13											