

LAND CORNER RECORDATION CERTIFICATE
Filing Requirement of Act 74, Mich. P.A. 1970

OK - T. SMITH

For corners in


Table with columns: Oakland (County), Located In: Oxford Twp., Corner Code #. Rows include Public Land Survey, Property Controlling in Section, and Miscellaneous Property in Sec.

\$ 7.00 MISCELLANEOUS RECORDING
\$ 2.00 REMONUMENTATION
15 NOV 94 8:56 A.M. RECEIPT# 138
PAID RECORDED - OAKLAND COUNTY
LYNN D. ALLEN, CLERK/REGISTER OF DEEDS
Compliance with ACT 345, P.A. 1990

APPROVED ON: 8/31/94
OAKLAND COUNTY REMONUMENTATION
PEER GROUP COMMITTEE

Register of Deeds Stamp & File Number

4. Lot No. , Recorded Plat
5. Private Claims

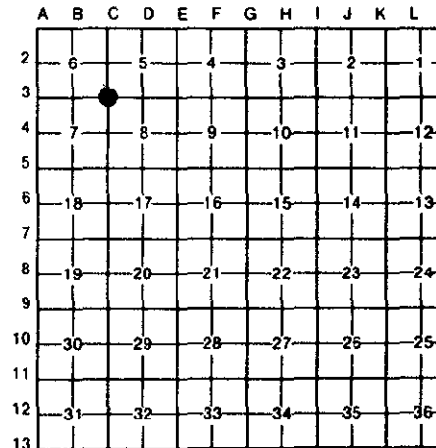

I, Huston K. Kennedy, in a field survey on August 10, 1994, do hereby certify that under requirements of P.A. 74, Michigan P.A. of 1970, the corner points mentioned in lines 1 and 2 above were in conformance with regulations and rules therefore as required in the current manual of survey instructions of the United States Department of the Interior, Bureau of Land Management or by a decree of a Court of Law and/or that the corner points mentioned in lines 3, 4 and 5 above were in conformance with the rules of the Michigan Board of Land Surveyors or by a Decree of a Court of Law, established, re-established, monumented, re-monumented, recovered, found as expressed below:

NOTE: Not more than 4 corners, all in the same town and range, may be recorded on this certificate.

A. Description of original monument and accessories and/or subsequent restoration:

- 1818-GLO Wampler, D.S.; Set Post; 12" White Oak S77°E 37 Links; 8" White Oak N32 1/2°W 103 Links
1.) 1973-Feldhauser, P.S. #10685; LCRC L.6060, Pg.14 - Fnd 5/8" Iron Rod
2.) 1973-Feldhauser, P.S. #10685; LCRC L.6156, Pg.680 - Fnd P.K. Nail in a cap, used same wit as 1973 LCRC
3.) 1975-Kennedy, P.S. #17623; LCRC L.6414, Pg.19 - Fnd 1/2" Iron Rod
4.) 1977-Kennedy, P.S. #17623; LCRC L.7067, Pg.314 - Fnd 1/2" Iron Rod
5.) 1982-Kennedy, P.S. #17623; LCRC L.8132, Pg.538 - Fnd capped 1 1/2" Iron Pipe
6.) 1973-Feldhauser, P.S. #10685; Survey L.6156, Pg.676 - Fnd
7.) 1974-Kennedy, P.S. #17623; Survey L.6293, Pg.718 - Fnd 1/2" Iron Rod, used same wit as 1975 LCRC
8.) 1977-Kennedy, P.S. #17623; Unrecorded Survey - Fnd 1/2" Iron Rod
9.) 1979-Kennedy, P.S. #17623; Unrecorded Survey - Fnd 1/2" Iron Rod

B. Description of corner evidence found and/or method applied in restoring or reestablishing corner:

1994 Kennedy Surveying, Inc. - Kennedy, P.S. #17623 - Fnd 1/2" Iron Rod that is located 3.6' North of the centerline of Oakwood Road, which is bituminous surface and in the center of Coats Road, which is a gravel surface to the South.

Witnesses from LCRC #1, 3 & 4 were used to recover and verify the location of the found 1/2" Iron Rod.

I accepted the found 1/2" Iron Rod as the best evidence of the original corner position.

C. Description of monument for corner and accessories established to perpetuate locating the position of the corner:

- C-3 I replaced the found 1/2" Iron Rod with a 5/8" x 24" Iron Rod w/2" diameter brass cap stamped Oakland County Remonumentation, PS #17623 in a new Monument Box.
N24°E 37.64' Set PK & Remon. Washer NW face 36" Walnut
S69°E 68.60' Set PK & Remon. Washer North face Power Pole
S20°E 100.32' Set PK & Remon. Washer SW face 21" Ash
S44°W 46.39' Set PK & Remon. Washer SE face Power Pole

The selected location is accepted by me and is generally accepted by Professional Surveyors as the best available evidence of the position of the original corner.



Signed by [Signature]
Surveyor's Michigan License No. 17623

Date September 14, 1994