

Compliance with ACT 345, P.A. 1990

LAND CORNER RECORDATION CERTIFICATE

Filing Requirement of Act 74, Mich. P.A. 1970

APPROVED ON: 9-7-94 OAKLAND COUNTY REMONUMENTATION PEER GROUP COMMITTEE

For corners in

Oakland (County)

Located In: Oxford Twp. Corner Code #

Table with 4 columns: Survey Type, T, R, Corner Code. Includes rows for Public Land Survey, Property Controlling in Section, and Miscellaneous Property in Sec.

\$ 7.00 MISCELLANEOUS RECORDING \$ 2.00 REMONUMENTATION 24 OCT 94 8:49 A.M. RECEIPT# 33B PAID RECORDED - OAKLAND COUNTY LYNN D. ALLEN, CLERK/REGISTER OF DEEDS


OK - T. SMITH

Register of Deeds Stamp & File Number

4. Lot No. Recorded Plat 5. Private Claims

I, Huston K. Kennedy, in a field survey on August 1, 1994, do hereby certify that under requirements of P.A. 74, Michigan P.A. of 1970, the corner points mentioned in lines 1 and 2 above were in conformance with regulations and rules therefore as required in the current manual of survey instructions of the United States Department of the Interior, Bureau of Land Management or by a decree of a Court of Law and/or that the corner points mentioned in lines 3, 4 and 5 above were in conformance with the rules of the Michigan Board of Land Surveyors or by a Decree of a Court of Law; established, re-established, monumented, re-monumented, recovered, found as expressed below:

NOTE: Not more than 4 corners, all in the same town and range, may be recorded on this certificate.

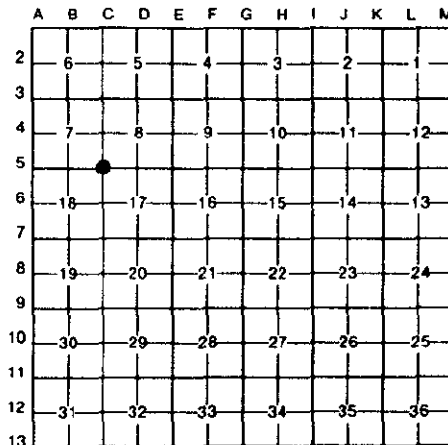

A. Description of original monument and accessories and/or subsequent restoration:

- 1817-GLO Wanpler, D.S.; Set Post 12" Birch N51°E 23 Links; 6" White Walnut S77°E 16 Links 1.) 1972-Jones, P.S. #16045; LCRC L.5975, Pg.324-325 - Fnd 3/4" Iron Pipe 2.) 1974-Kennedy, P.S. #17623; LCRC L.6379, Pg.289 - Fnd 1" Iron Pipe 3.) 1969-Graves, P.S.; Unrecorded Witnesses - Fnd 3/4" Iron Pipe 4.) 1974-Kennedy, P.S. #17623; Unrecorded Survey - Fnd 1" Iron Pipe 5.) 1975-Kennedy, P.S. #17623; Unrecorded Survey - Fnd 1" Iron Pipe 6.) 1984-Kennedy, P.S. #17623; Unrecorded Survey - Fnd 1/2" Iron Pipe 7.) 1989-Kennedy, P.S. #17623; Unrecorded Survey - Fnd 1/2" Iron Pipe 8.) 1993-Kennedy, P.S. #17623; Unrecorded Survey - Fnd 1/2" Iron Pipe 9.) 1987-Leiber, P.S. #27466; Unrecorded Survey - Fnd Iron Pipe

7.00 Amt 2.00 file

B. Description of corner evidence found and/or method applied in restoring or reestablishing corner:


1994 Kennedy Surveying, Inc. - Kennedy, P.S. #17623 - Fnd 1/2" Iron Rod inside a 5/8" Iron Pipe that is located 6" under the road surface in the center of Coats Road in the center of Hummer Lake Road. Both are gravel roads. The pipe is 18" deep. Witnesses from Unrecorded Surveys #6, 7, 8 & 9 were used to recover and verify the location of the found 1/2" Iron Rod inside a 5/8" Iron Pipe.

I accepted the found 1/2" Iron Rod inside a 5/8" Iron Pipe as the best evidence of the original corner position.

C. Description of monument for corner and accessories established to perpetuate locating the position of the corner:

C-5 I replaced the found 1/2" Iron Rod inside a 5/8" Iron Pipe with a 5/8" x 24" Iron Rod w/2" diameter brass cap stamped Oakland County Remonumentation, PS #17623. N41°W 60.78' Set PK & Remon. Washer NE face 27" Oak S51°W 54.84' Set PK & Remon. Washer SE face 13" Maple S46°E 56.87' Set PK & Remon. Washer NE face 12" Maple N43°E 51.04' Set PK & Remon. Washer NW face 22" Oak

The selected location is accepted by me and is generally accepted by Professional Surveyors as the best available evidence of the position of the original corner.

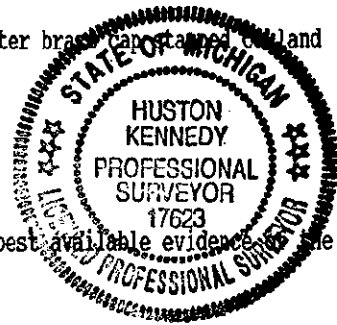

Signed by [Signature] Surveyor's Michigan License No. 17623

Date September 1, 1994