

LAND CORNER RECORDATION CERTIFICATE  
Filing Requirement of Act 74, Mich. P.A. 1970

OK - T. SMITH

For corners in

Oakland  
(County)

Located In: Oxford  
Twp.

Corner Code #

- 1. Public Land Survey      T 5N   R 10E      E-5
- T        R
- T        R
- T        R
- 2. Property Controlling    S        T        R
- in Section                S        T        R
- 3. Miscellaneous            S        T        R
- Property in Sec.         S        T        R

\$ 7.00 MISCELLANEOUS RECORDING  
\$ 2.00 REMONUMENTATION  
24 OCT 94 8:50 A.M.      RECEIPT# 338  
PAID                      RECORDED - OAKLAND COUNTY  
LYNN D. ALLEN, CLERK/REGISTER OF DEEDS


Compliance with  
ACT 345, P.A. 1990

APPROVED ON: 9-7-94  
OAKLAND COUNTY REMONUMENTATION  
PEER GROUP COMMITTEE  
Register of Deeds Stamp & File Number

- 4. Lot No. \_\_\_\_\_, Recorded Plat \_\_\_\_\_
- 5. Private Claims \_\_\_\_\_

I, Huston K. Kennedy, in a field survey on August 1, 19 94, do hereby certify that under requirements of P.A. 74, Michigan P.A. of 1970, the corner points mentioned in lines 1 and 2 above were in conformance with regulations and rules therefore as required in the current manual of survey instructions of the United States Department of the Interior, Bureau of Land Management or by a decree of a Court of Law and/or that the corner points mentioned in lines 3, 4 and 5 above were in conformance with the rules of the Michigan Board of Land Surveyors or by a Decree of a Court of Law; established, re-established, monumented, re-monumented, recovered, found as expressed below:

**NOTE: Not more than 4 corners, all in the same town and range, may be recorded on this certificate.**

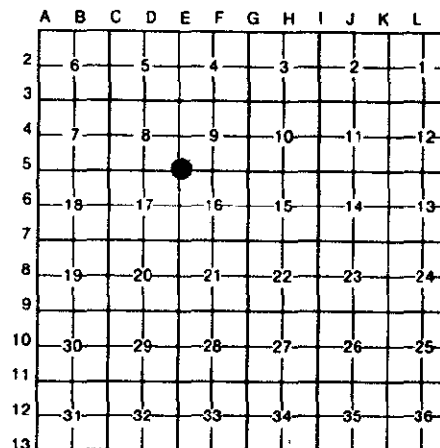

A. Description of original monument and accessories and/or subsequent restoration:

- 1818-GLO - Post not set
- 1.) 1982-Kennedy, P.S. #17623; LCRC L.8132, Pg.540 - Fnd 1/2" Iron Rod
- 2.) 1980-Kennedy, P.S. #17623; Unrecorded Survey - Fnd 1/2" Iron Rod
- 3.) 1991-Kennedy, P.S. #17623; Unrecorded Survey - Fnd 1/2" Iron Rod

7.00  
2.00  
file

B. Description of corner evidence found and/or method applied in restoring or reestablishing corner:

1994 Kennedy Surveying, Inc. - Kennedy, P.S. #17623 - Fnd 1/2" Iron Rod located 2" under the road surface and 2' North of the center of Hummer Lake Road, which is gravel surface. Fence and tree row extending to the North & South.

Witnesses from LCRC #1 were used to recover and verify the location of the found 1/2" Iron Rod.

I accepted the found 1/2" Iron Rod as the best evidence of the original corner position.

C. Description of monument for corner and accessories established to perpetuate locating the position of the corner:

E-5 I replaced the found 1/2" Iron Rod with a 5/8" x 24" Iron Rod w/2" diameter brass cap stamped Oakland County Remonumentation, PS #17623.

- S27°E 34.65' Set PK & Remon. Washer West face 27" Willow
- S05°E 32.32' Set PK & Remon. Washer West face 10" Ash
- N51°W 28.51' Set PK & Remon. Washer SW face 8" Elm
- N40°E 21.82' Set PK & Remon. Washer SE face 17" Willow

The selected location is accepted by me and is generally accepted by Professional Surveyors as the available evidence of the position of the original corner.



Signed by [Signature] Date September 8, 1994  
Surveyor's Michigan License No. 17623