

LAND CORNER RECORDATION CERTIFICATE

Filing Requirement of Act 74, Mich. P.A. 1970

For corners in Oakland (County)

Located In: Oxford Twp. Corner Code #


\$ 7.00 MISCELLANEOUS RECORDING
\$ 2.00 REMONUMENTATION
14 JUL 95 8:38 A.M. RECEIPT# 9B
PAID RECORDED - OAKLAND COUNTY
LYNN D. ALLEN, CLERK/REGISTER OF DEEDS

Table with 4 columns: Item, T, R, and Code. Row 1: Public Land Survey, T 5N, R 10E, E-11. Row 2: Property Controlling in Section, S, T, R. Row 3: Miscellaneous Property in Section, S, T, R.

Compliance with ACT 345, P.A. 1990

APPROVED ON: 6-14-95 Tom S
OAKLAND COUNTY REMONUMENTATION PEER GROUP COMMITTEE
Register of Deeds Stamp & File Number

4. Lot No. _____, Recorded Plat _____
5. Private Claims _____

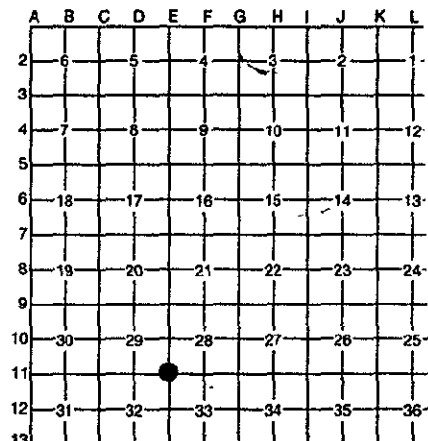

I, Huston K. Kennedy, in a field survey on April 26, 19 95, do hereby certify that under requirements of P.A. 74, Michigan P.A. of 1970, the corner points mentioned in lines 1 and 2 above were in conformance with regulations and rules therefore as required in the current manual of survey instructions of the United States Department of the Interior, Bureau of Land Management or by a decree of a Court of Law and/or that the corner points mentioned in lines 3, 4 and 5 above were in conformance with the rules of the Michigan Board of Professional Surveyors or by a Decree of a Court of Law; established, re-established, monumented, re-monumented, recovered, found as expressed below:

NOTE: Not more than 4 corners, all in the same town and range, may be recorded on this certificate.

A. Description of original monument and accessories and/or subsequent restoration:

- 1818-GLO Wampler, D.S.; Set Post 12" White Oak S22'E 75 Links
1.) 1974-Pawlaczyk, PS #17632; LCRC L.6327, Pg.447 & 448 - Fnd Set Nail
2.) 1979-Kennedy, PS #17623; LCRC L.7524, Pg.757 - Fnd P.K. Nail
3.) 1989-Kennedy, PS #17623; LCRC L.10980, Pg.235 - Fnd P.K. Nail
4.) 1974-Pawlaczyk, PS #17632; Survey L.6327, Pg.443 - Fnd Set Nail, used same wit as 1974 LCRC
5.) 1978-Kennedy, PS #17623; Unrecorded Survey - Fnd P.K. Nail, used same wit as 1979 LCRC
6.) 1992-Kennedy, PS #17623; Unrecorded Survey - Fnd P.K. Nail, used same wit as 1989 LCRC
7.) 1994-Kennedy, PS #17623; Unrecorded Survey - Fnd P.K. Nail, used same wit as 1989 LCRC

B. Description of corner evidence found and/or method applied in restoring or reestablishing corner:

1995 Kennedy Surveying, Inc. - Kennedy, PS #17623 - Fnd 1/2" Iron Rod w/cap #26453 in a Monument Box 5.50 feet South of the centerline of Drahrer Road extending to the East & West, which has a bituminous surface and 19.00 feet West of the centerline of Hilberg Avenue extending to the North, which has a gravel surface.

Witnesses from LCRC #1, 2 & 3 were used to recover and verify the location of the found 1/2" Iron Rod w/cap #26453 in a Monument Box.

I accepted the found 1/2" Iron Rod w/cap #36453 in a Monument Box as the best evidence of the original corner position.

FIELD MEASUREMENTS BETWEEN

E-11 to F-11 2848.55 Ft., GLO = 40 chains or 2640.00 Ft.
E-11 to E-12 2758.50 Ft., GLO = 40 chains or 2640.00 Ft.

C. Description of monument for corner and accessories established to perpetuate locating the position of the corner:


E-11 I replaced the found with 1/2" Iron Rod with a 5/8" x 24" Iron Rod w/2" diameter brass cap stamped Oakland County Remonumentation PS #17623 in a existing Monument Box.
Due South 35.33' Set PK & Remon. Washer East face 19" & 21" Twin Oak
S36°W 88.85' Set PK & Remon. Washer NW face Power Pole
S62°W 148.21' Set PK & Remon. Washer NW face Power Pole
N07°W 105.77' Set PK & Remon. Washer East face 14" Oak

The selected location is accepted by me and is generally accepted by Professional Surveyors as the best available evidence of the original corner position.

Signed by [Signature]
Surveyor's Michigan License No. 17623

Date June 14, 1995

FORM APPROVED BY MICHIGAN STATE BOARD OF PROFESSIONAL SURVEYORS

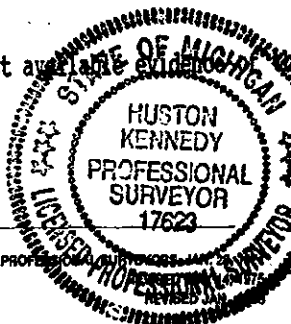

7.00
2.00 (PL)