

LIBER 15175 PG 141

DEC 29 91 3 25 98 1

OK - T. SMITH

LAND CORNER RECORDATION CERTIFICATE  
Filing Requirement of Act 74, Mich. P.A. 1970

Compliance with  
ACT 345, P.A. 1990

For corners in  
Oakland  
(County)

Located In: Oxford Corner Code #  
Twp.


APPROVED ON: 12-14-94  
OAKLAND COUNTY REMONUMENTATION  
PEER GROUP COMMITTEE

1. Public Land Survey	T <u>5N</u>	R <u>10E</u>	<u>F-3</u>
	T	R	
	T	R	
	T	R	
2. Property Controlling in Section	S	T	R
	S	T	R
3. Miscellaneous Property in Sec.	S	T	R
	S	T	R

\$ 7.00 MISCELLANEOUS RECORDING  
\$ 2.00 REMONUMENTATION  
29 DEC 94 9:46 A.M. RECEIPT# 46B  
PAID RECORDED - OAKLAND COUNTY  
LYNN D. ALLEN, CLERK/REGISTER OF DEEDS

Register of Deeds Stamp & File Number

- 4. Lot No. \_\_\_\_\_, Recorded Plat \_\_\_\_\_
- 5. Private Claims \_\_\_\_\_

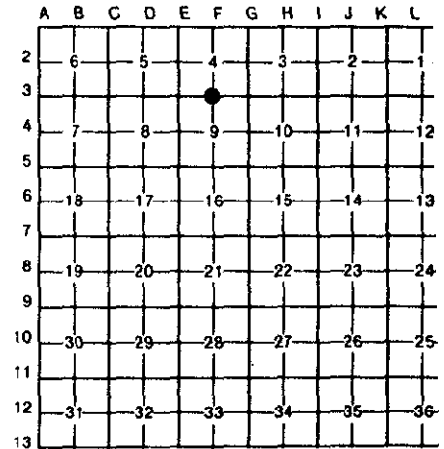

I, Huston K. Kennedy, in a field survey on October 31, 19 94, do hereby certify that under requirements of P.A. 74, Michigan P.A. of 1970, the corner points mentioned in lines 1 and 2 above were in conformance with regulations and rules therefore as required in the current manual of survey instructions of the United States Department of the Interior, Bureau of Land Management or by a decree of a Court of Law and/or that the corner points mentioned in lines 3, 4 and 5 above were in conformance with the rules of the Michigan Board of Land Surveyors or by a Decree of a Court of Law, established, re-established, monumented, re-monumented, recovered, found as expressed below:

**NOTE: Not more than 4 corners, all in the same town and range, may be recorded on this certificate.**

A. Description of original monument and accessories and/or subsequent restoration:

- 1818-GLO Wampler, D.S.; Set Post; 8" Black Oak N05°W 29 Links; Black Oak N30°W 27 Links
- 1.) 1972-Buckerfield, P.S. #10868; LCRC L.5892, Pg.263 - Fnd 1/2" Iron Rod
- 2.) 1974-Kennedy, P.S. #17623; LCRC L.6379, Pg.289 - Fnd Bolt Spike
- 3.) 1979-Kobs, P.S. #14097; LCRC L.7455, Pg.805 - Fnd 1" x 1" Square Iron Bar
- 4.) 1982-Kennedy, P.S. #17623; LCRC L.8132, Pg.538 - Fnd 1/2" Iron Rod
- 5.) 1983-Kennedy, P.S. #17623; LCRC L.8332, Pg.346 - Fnd Bolt Spike
- 6.) 1972-Buckerfield, P.S. #10868; Survey L.5880, Pg.273 - Fnd Bolt Spike, used same wit as 1972 LCRC
- 7.) 1972-Murphy, P.S. #9657; Survey L.5950, Pg.210 - Fnd Bolt Spike
- 8.) 1975-Kennedy, P.S. #17623; Survey L.6490, Pg.322 - Fnd 1/2: Iron Rod, used same wit as 1974 LCRC
- 9.) 1977-Henderson, P.S. #16043; Survey L.6845, Pg.387 - Fnd Iron Rod

B. Description of corner evidence found and/or method applied in restoring or reestablishing corner:

1994 Kennedy Surveying, Inc - Kennedy, P.S. #17623 - Fnd Bolt Spike that is located 10" under the road surface, 7.50' West of the center of Metamora Road and 10' South of the center of Oakwood Road. Both are gravel surface roads. Also found second 1/2" Iron Rod 1.3' to the North and 2.10' to the East, also found third 1/2" Capped Iron Rod .72' to the South and 7.37' to the East. The number on the cap cannot be read.

The witnesses from LCRC #1 & 2 were used to recover and verify the location of the found Bolt Spike.

I accepted the found Bolt Spike as the best evidence of the original corner position.

C. Description of monument for corner and accessories established to perpetuate locating the position of the corner:

- F-3 I replaced the found Bolt Spike with a 5/8" x 24" Iron Rod w/2" diameter brass cap stamped Oakland County Remonumentation, PS #17623.
- S69°E 91.92' Set PK & Remon. Washer NE face 28" Walnut
- N67°W 49.09' Set PK & Remon. Washer SW face 30" Oak
- S37°W 51.94' Set PK & Remon. Washer SE face Power Pole
- S34°E 48.73' Set PK & Remon. Washer NE face Power Pole

The selected location is accepted by me and is generally accepted by Professional Surveyors as the best available evidence of the position of the original corner.



Signed by Huston K. Kennedy  
Surveyor's Michigan License No. 17623

Date December 15, 1994