

LAND CORNER RECORDATION CERTIFICATE

OK - T. SMITH

Filing Requirement of Act 74, Mich. P.A. 1970 7.00 MISCELLANEOUS RECORDING

For corners in


Oakland (County) Located In: Oxford Twp. Corner Code # F-5

1. Public Land Survey	T <u>5N</u> R <u>10E</u>	<u>F-5</u>
	T _____ R _____	_____
	T _____ R _____	_____
	T _____ R _____	_____
2. Property Controlling in Section	S _____ T _____ R _____	_____
	S _____ T _____ R _____	_____
3. Miscellaneous Property in Sec.	S _____ T _____ R _____	_____
	S _____ T _____ R _____	_____
4. Lot No. _____, Recorded Plat _____		
5. Private Claims _____		

\$ 2.00 REMONUMENTATION  
 24 OCT 94 8:50 A.M. RECEIPT# 33B  
 PAID RECORDED - OAKLAND COUNTY  
 LYNN D. ALLEN, CLERK/REGISTER OF DEEDS

Compliance with  
 ACT 345, P.A. 1990

APPROVED ON: R-7-94  
 OAKLAND COUNTY REMONUMENTATION  
 PEER GROUP COMMITTEE  
 Register of Deeds Stamp & File Number

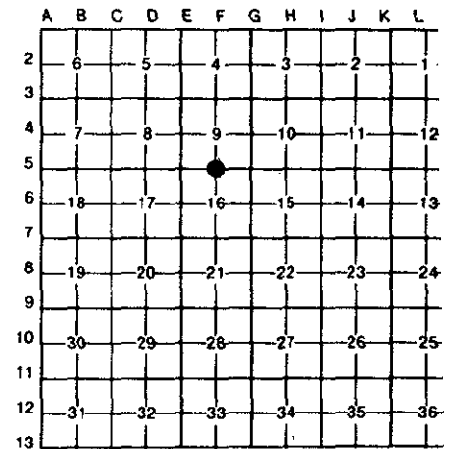

I, Huston K. Kennedy, in a field survey on August 1, 19 94, do hereby certify that under requirements of P.A. 74, Michigan P.A. of 1970, the corner points mentioned in lines 1 and 2 above were in conformance with regulations and rules therefore as required in the current manual of survey instructions of the United States Department of the Interior, Bureau of Land Management or by a decree of a Court of Law and/or that the corner points mentioned in lines 3, 4 and 5 above were in conformance with the rules of the Michigan Board of Land Surveyors or by a Decree of a Court of Law; established, re-established, monumented, re-monumented, recovered, found as expressed below:

**NOTE: Not more than 4 corners, all in the same town and range, may be recorded on this certificate.**

A. Description of original monument and accessories and/or subsequent restoration:

- 1818-GLO Wampler, D.S.; Set Post 12" White Oak N01\*W 61 Links; 6" Black Oak S68\*E 12 Links
- 1.) 1972-Buckerfield, P.S. #10868; LCRC L.5892, Pg.259 - Fnd 1/2" Iron Rod
- 2.) 1972-Jones, P.S. #16045; LCRC L.5975, Pgs.324-325 - Fnd 3/8" Iron Rod
- 3.) 1977-Kennedy, P.S. #17623; LCRC L.7067, Pg.314 - Fnd 1/2" Iron Rod
- 4.) 1978-Jones, P.S. #16045; LCRC L.7177, Pg.611 - Fnd 3/8" Iron Rod
- 5.) 1983-Kennedy, P.S. #17623; LCRC L.8332, Pg.346 - Fnd 1/2" Iron Rod
- 6.) 1985-Kennedy, P.S. #17623; LCRC L.9000, Pg.574 - Fnd 1/2" Iron Rod
- 7.) 1972-Lohff, P.S. #13791; Survey L.5905, Pg.814 - Fnd 3/8" Iron Rod, used same wit as 1972 LCRC
- 8.) 1974-Kennedy, P.S. #17623; Survey L.6390, Pg.485 - Fnd 1/2" Iron Rod, used same wit as 1977 LCRC
- 9.) 1986-Reichert, P.S. #30099; Survey L.9622, Pg.762 - Fnd 1/2" Iron Rod

*7.00 Paid  
2.00 file*

B. Description of corner evidence found and/or method applied in restoring or reestablishing corner:

1994 Kennedy Surveying, Inc. - Kennedy, P.S. #17623 - Fnd 1/2" Iron Rod that is located 4" under the road surface and 2' North of the center of Hummer Lake Road, which is gravel surface. Also found a 5/8" Iron Rod 1.70' to the West.

Witnesses from LCRC #1 & 6 were used to recover and verify the location of the found 1/2" Iron Rod.

I accepted the found 1/2" Iron Rod as the best evidence of the original corner position.

C. Description of monument for corner and accessories established to perpetuate locating the position of the corner:

- F-5 I replaced the found 1/2" Iron Rod with a 5/8" x 24" Iron Rod w/2" diameter brass cap stamped Oakland County Remonumentation, PS 17623.
- S38°W 28.79' Set PK & Remon. Washer SE face 10" Cherry
- S69°E 52.94' Set PK & Remon. Washer NE face 8" Elm
- N40°E 39.03' Set PK & Remon. Washer NW face 21" Elm
- N47°E 50.10' Set PK & Remon. Washer SE face 24" Elm

The selected location is accepted by me and is generally accepted by Professional Surveyors as the best available evidence of the position of the original corner.



Signed by [Signature] Date September 8, 1994  
 Surveyor's Michigan License No. 17623