

LAND CORNER RECORDATION CERTIFICATE

Filing Requirement of Act 74, Mich. P.A. 1970 \$ 7.00 MISCELLANEOUS RECORDING

For corners in Oakland (County)

Located In: Oxford Twp. Corner Code #

\$ 2.00 REMONUMENTATION  
14 JUL 95 8:37 A.M. RECEIPT# 98  
PAID RECORDED - OAKLAND COUNTY  
LYNN D. ALLEN, CLERK/REGISTER OF DEEDS

1. Public Land Survey	T	<u>5N</u>	R	<u>10E</u>	<u>G-13</u>
	T	_____	R	_____	_____
	T	_____	R	_____	_____
	T	_____	R	_____	_____
2. Property Controlling in Section	S	_____	T	_____	_____
	S	_____	T	_____	_____
3. Miscellaneous Property in Section	S	_____	T	_____	_____
	S	_____	T	_____	_____

Compliance with ACT 345, P.A. 1990

APPROVED ON: 6-14-95 Tom S  
OAKLAND COUNTY REMONUMENTATION PEER GROUP COMMITTEE

Register of Deeds Stamp & File Number

4. Lot No. \_\_\_\_\_, Recorded Plat \_\_\_\_\_  
5. Private Claims \_\_\_\_\_

I, Huston K. Kennedy, in a field survey on April 26, 19 95, do hereby certify that under requirements of P.A. 74, Michigan P.A. of 1970, the corner points mentioned in lines 1 and 2 above were in conformance with regulations and rules therefore as required in the current manual of survey instructions of the United States Department of the Interior, Bureau of Land Management or by a decree of a Court of Law and/or that the corner points mentioned in lines 3, 4 and 5 above were in conformance with the rules of the Michigan Board of Professional Surveyors or by a Decree of a Court of Law; established, re-established, monumented, re-monumented, recovered, found as expressed below:

A	B	C	D	E	F	G	H	I	J	K	L
2	6	5	4	3	2	1					
3											
4	7	8	9	10	11	12					
5											
6	18	17	16	15	14	13					
7											
8	19	20	21	22	23	24					
9											
10	30	29	28	27	26	25					
11											
12	31	32	33	34	35	36					
13											

NOTE: Not more than 4 corners, all in the same town and range, may be recorded on this certificate.

A. Description of original monument and accessories and/or subsequent restoration:

1818-GLO Wampler, D.S.; Set Post 12" Black Oak N11°E 41 Links; 6" Black Oak S61°W 65 Links

1.) 1991-Patterson, PS #17631; LCRC L.12172, Pg.707 - Fnd 1/2" Iron Pipe in concrete in a 4" Iron Pipe

B. Description of corner evidence found and/or method applied in restoring or reestablishing corner:

1995 Kennedy Surveying, Inc. - Kennedy, PS #17623 - Fnd 5/8" Iron Pipe in concrete in 4" pipe in a tree-fence line extending East West, 17.5 feet North of the centerline of Nakomas Road extending to the East & West, Which has a gravel surface and 21 feet East of driveway for house #1437.

Witnesses from LCRC #1 were used to recover and verify the location of the found 5/8" Iron Pipe in concrete in 4" Pipe.

I accepted the found 5/8" Iron Pipe in concrete in 4" pipe as the best evidence of the original corner position.

FIELD MEASUREMENTS BETWEEN

G-13 to F-13 2798.95 Ft., GLO = 40 chains or 2640.00 Ft.  
G-13 to H-13 2852.12 Ft., GLO = 40 chains or 2640.00 Ft.


C. Description of monument for corner and accessories established to perpetuate locating the position of the corner:

G-13 I accepted the found 5/8" Iron Pipe in concrete a 4" pipe with a 5/8" x 24" Iron Rod w/2" diameter brass cap stamped Oakland County Remonumentation, PS #17623  
N87°E 15.05' Set PK & Remon. Washer South face 17" Oak  
N81°W 3.45' Set PK & Remon. Washer NE face 19" Oak  
S80°W 16.38' Set PK & Remon. Washer SE face 15" Oak  
S23°E 42.12' Set PK & Remon. Washer SE face 22" Cherry

The selected location is accepted by me and is generally accepted by Professional Surveyors as the best available position of the original corner.

Signed by [Signature]  
Surveyor's Michigan License No. 17623

Date June 14, 1995

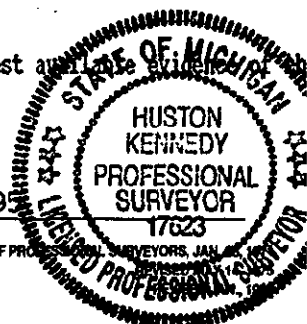

7.00  
2.00  
RM