

LAND CORNER RECORDATION CERTIFICATE
Filing Requirement of Act 74, Mich. P.A. 1970

For corners in
Oakland
(County)

Located In: Oxford Township Corner Code #H

- 1. Public Land Survey T 5 N R 10 E H-3
2. Property Controlling in Section S T R
3. Miscellaneous Property in Sec. S T R


OK - T. SMITH
\$ 7.00 MISCELLANEOUS RECORDING
\$ 2.00 REMONUMENTATION
8 SEP 94 3:19 P.M. RECEIPT# 134B
PAID RECORDED - OAKLAND COUNTY
LYNN D. ALLEN, CLERK/REGISTER OF DEEDS
Compliance with ACT 345, P.A. 1990

APPROVED ON: 1-5-94
OAKLAND COUNTY REMONUMENTATION PEER GROUP COMMITTEE

Register of Deeds Stamp & File Number

- 4. Lot No. , Recorded Plat
5. Private Claims

I, Huston K. Kennedy, in a field survey on November 4, 1993, do hereby certify that under requirements of P.A. 74, Michigan P.A. of 1970, the corner points mentioned in lines 1 and 2 above were in conformance with regulations and rules therefore as required in the current manual of survey instructions of the United States Department of the Interior, Bureau of Land Management or by a decree of a Court of Law and/or that the corner points mentioned in lines 3, 4 and 5 above were in conformance with the rules of the Michigan Board of Land Surveyors or by a Decree of a Court of Law; established, re-established, monumented, re-monumented, recovered, found as expressed below:

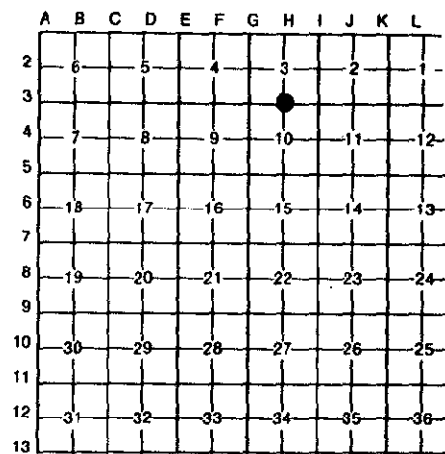

NOTE: Not more than 4 corners, all in the same town and range, may be recorded on this certificate.

A. Description of original monument and accessories and/or subsequent restoration:

- 1817 GLO - Wampler, D.S.; Post set; No witnesses
1980 Pangus, P.S. #21578; LCRC L.7859, Pg.427-428 - Fnd railroad spike

Handwritten signature/initials.

B. Description of corner evidence found and/or method applied in restoring or reestablishing corner:

1993 Kennedy Surveying, Inc. - Huston Kennedy, P.S. #17623 - Fnd 1/2" iron pipe 3' South of the center of Oakwood Road, which is gravel. The witness points no longer exist, but the fence post and the witness trees from the LCRC above still exist. They were used to recover and verify the found 1/2" iron pipe that has replaced the railroad spike.

I accepted the found 1/2" iron pipe as the best evidence of the original corner position.

C. Description of monument for corner and accessories established to perpetuate locating the position of the corner:

H-3 I replaced the found 1/2" iron rod with a 5/8" x 24" iron rod with a 2" diameter cap stamped Oakland County Remonumentation P.S. #17623.

- Due North-28.09 ft-Set PK/Remon. Tag above existing witness East face fence post
S32°E-32.62 ft-Set PK/Remon. Tag above existing witness SW face 7" Elm
S08°W-43.87 ft-Set PK/Remon. Tag West face 8" Cedar
S57°W-60.28 ft-Set PK/Remon. Tag NW face 8" Elm

The selected location is accepted by me and is generally accepted by Professional Surveyors as the best available evidence of the position of the original position of the corner.

Signed by [Signature]
Surveyor's Michigan License No. 17623

Date March 23, 1994

