

LAND CORNER RECORDATION CERTIFICATE

Filing Requirement of Act 74, Mich. P.A. 1970 \$ 7.00

MISCELLANEOUS RECORDING

For corners in Oakland (County)

Located In: Oxford Twp. Corner Code #

\$ 2.00 REMONUMENTATION
14 JUL 95 8:37 A.M. RECEIPT# 98
PAID RECORDED - OAKLAND COUNTY
LYNN D. ALLEN, CLERK/REGISTER OF DEEDS

Table with 5 rows and 4 columns: Survey Type, S/T, R, H-11

Compliance with ACT 345, P.A. 1990

APPROVED ON: 6-14-95 Tom S
OAKLAND COUNTY REMONUMENTATION
PEER GROUP COMMITTEE

Register of Deeds Stamp & File Number

4. Lot No. , Recorded Plat
5. Private Claims

I, Huston K. Kennedy, in a field survey on April 26, 1995, do hereby certify that under requirements of P.A. 74, Michigan P.A. of 1970, the corner points mentioned in lines 1 and 2 above were in conformance with regulations and rules therefore as required in the current manual of survey instructions of the United States Department of the Interior, Bureau of Land Management or by a decree of a Court of Law and/or that the corner points mentioned in lines 3, 4 and 5 above were in conformance with the rules of the Michigan Board of Professional Surveyors or by a Decree of a Court of Law; established, re-established, monumented, re-monumented, recovered, found as expressed below:

NOTE: Not more than 4 corners, all in the same town and range, may be recorded on this certificate.

A. Description of original monument and accessories and/or subsequent restoration:

1818-GLO Wampler, D.S.; Set Post 6" Black Oak S44°W 66 Links

- 1.) 1973-Lester, PS #18998; LCRC L.6028, Pg.643 - Fnd 1/2" Bar in a Monument Box
2.) 1976-Kennedy, PS #17623; LCRC L.6675, Pg.570 - Fnd 1/2" Iron Pin in a Monument Box
3.) 1994-Kennedy, PS #17623; LCRC L.14419, Pg.398 - Fnd 1/2" Iron Rod in a Monument Box
4.) 1976-Kennedy, PS #17623; Survey L.6675, Pg.567 - Fnd 1/2" Iron Rod in a Monument Box, used same wit as 1976 LCRC
5.) 1984-Kennedy, PS #17623; Survey L.8809, Pg.448 - Fnd 1/2" Iron Rod in a Monument Box, used same wit as 1994 LCRC

B. Description of corner evidence found and/or method applied in restoring or reestablishing corner:

1995 Kennedy Surveying, Inc. - Kennedy, PS #17623 - Fnd 1/2" Iron Rod in a Monument Box, 1 foot South of the centerline of Drahne Road extending to the East & West, which has a bituminous surface and 4 feet West of the centerline of Pontiac Road extending to the North, which has a bituminous surface. There is a tree-fence line extending to the South.

Witnesses from LCRC #1, 2 & 3 were used to recover and verify the location of the found 1/2" Iron Rod in a Monument Box.

I accepted the found 1/2" Iron Rod in a Monument Box as the best evidence of the original corner position.

FIELD MEASUREMENTS BETWEEN

H-11 to G-11 2693.75 Ft., GLO = 39.95 chains or 2636.70 Ft.
H-11 to I-1 2207.47 Ft., GLO = 39.95 chains or 2636.70 Ft.


C. Description of monument for corner and accessories established to perpetuate locating the position of the corner:

H-11 I replaced the 1/2" Iron Rod found with a 5/8" x 24" Iron Rod w/2" diameter brass cap stamped Oakland County Remonumentation PS #17623 in a existing Monument Box.
S13°E 49.25' Set PK & Remon. Washer SW face Power Pole
N56°W 131.11' Set PK & Remon. Washer SW face Power Pole
N21°E 157.27' Set PK & Remon. Washer NW face Power Pole
N39°E 53.39' Set PK & Remon. Washer NW face Power Pole

The selected location is accepted by me and is generally accepted by Professional Surveyors as the best available evidence position of the original corner.

Signed by [Signature]
Surveyor's Michigan License No. 17623

Date June 14, 1995

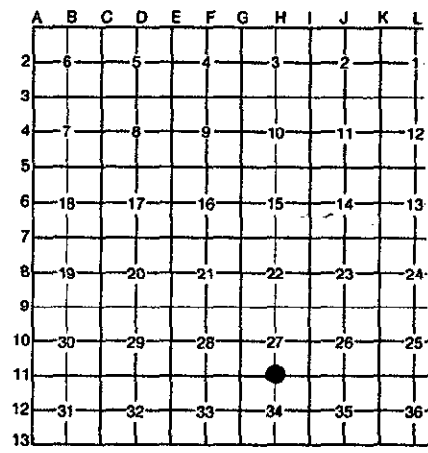

7.00
2-00