

LIBER 14960 PG 115

OK - T. SMITH
94 242445

LAND CORNER RECORDATION CERTIFICATE
Filing Requirement of Act 74, Mich. P.A. 1970

For corners in

Oakland

(County)

Located In: Oxford Township

Corner Code #

- 1. Public Land Survey T 5 N R 10 E I-2
- T R
- T R
- T R
- 2. Property Controlling S T R
- in Section S T R
- 3. Miscellaneous S T R
- Property in Sec. S T R


\$ 7.00 MISCELLANEOUS RECORDING
\$ 2.00 REMONUMENTATION
8 SEP 94 3:19 P.M. RECEIPT# 1345
PAID RECORDED - OAKLAND COUNTY
LYNN D. ALLEN, CLERK/REGISTER OF DEED

Compliance with
ACT 345, P.A. 1990

APPROVED ON: 1-5-94
OAKLAND COUNTY REMONUMENTATION
PEER GROUP COMMITTEE

Register of Deeds Stamp & File Number

- 4. Lot No. _____, Recorded Plat _____
- 5. Private Claims _____

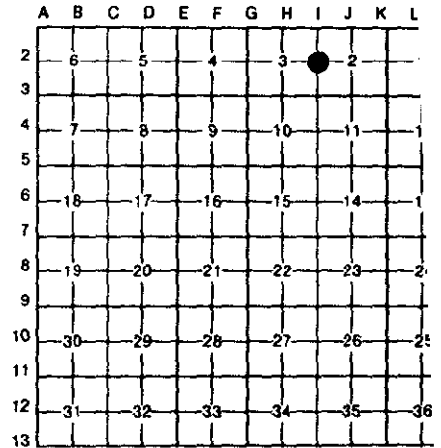

I, Huston K. Kennedy, in a field survey on November 4, 19 93, do hereby certify that under requirements of P.A. 74, Michigan P.A. of 1970, the corner points mentioned in lines 1 and 2 above were in conformance with regulations and rules therefore as required in the current manual of survey instructions of the United States Department of the Interior, Bureau of Land Management or by a decree of a Court of Law and/or that the corner points mentioned in lines 3, 4 and 5 above were in conformance with the rules of the Michigan Board of Land Surveyors or by a Decree of a Court of Law; established, re-established, monumented, re-monumented, recovered, found as expressed below:

NOTE: Not more than 4 corners, all in the same town and range, may be recorded on this certificate.

A. Description of original monument and accessories and/or subsequent restoration:

- 1817 GLO - Wampler, D.S.; Set post; 36" Cedar N46°W 0.81 lks
- 1982 Kennedy, P.S. #17623; LCRC L.8132, Pg.544 - Fnd 1/2" iron rod
- 1986 Gravlin, P.S. #23510; Survey L.9373, Pg.155-156 - Same wits as 1982 LCRC
- 1986 Reichert, P.S. #30099; Survey L.9457, Pg.549-550 - Same wits as 1982 LCRC

Handwritten signature/initials

B. Description of corner evidence found and/or method applied in restoring or reestablishing corner:

1993 Kennedy Surveying, Inc. - Huston Kennedy, P.S. #17623 - Fnd 1/2" iron rod in swamp. The iron rod was found based upon a survey done by McAlpine Engineering Co. in 1958. The found iron rod was witnessed in 1982 and the witness points from the 1982 LCRC still exist. They were used to recover and verify the found 1/2" iron rod.

I accepted the found 1/2" iron rod as the best evidence of the original corner position.

C. Description of monument for corner and accessories established to perpetuate locating the position of the corner:

I-2 I replaced the found 1/2" iron rod with a 4" diameter concrete monument 36" long with a 2" diameter cap stamped Oakland County Remonumentation P.S. #17623.

- N20°E-31.30 ft-Set PK/Remon. Tag SE face 9" Elm
- Due East-25.15 ft-Set PK/Remon. Tag above existing witness South face 11" Cedar
- N80°W-28.50-Set PK/Remon. Tag above existing witness North face 11" Cedar
- Due South-20.65 ft-Set PK/Remon. Tag SW face 10" Cedar

The selected location is accepted by me and is generally accepted by professional surveyors as the best available evidence of the position of the original position.



Signed by

Handwritten signature of Huston Kennedy

Date March 23, 1994

Surveyor's Michigan License No.

17623