

LAND CORNER RECORDATION CERTIFICATE
Filing Requirement of Act 74, Mich. P.A. 1970

Compliance with
ACT 345, P.A. 1990

APPROVED ON: 9-7-94
OAKLAND COUNTY REMONUMENTATION
PEER GROUP COMMITTEE

For corners in

Oakland
(County)

Located In: Oxford
Twp.

Corner Code #

- 1. Public Land Survey T 5N R 10E I-7
T R
T R
T R
- 2. Property Controlling S T R
in Section S T R
- 3. Miscellaneous S T R
Property in Sec. S T R


\$ 7.00 MISCELLANEOUS RECORDING
\$ 2.00 REMONUMENTATION
2 DEC 94 11:37 A.M. RECEIPT# 518
PAID RECORDED - OAKLAND COUNTY
LYNN D. ALLEN, CLERK/REGISTER OF DEEDS

OK - T. SMITH
Register of Deeds Stamp & File Number

- 4. Lot No. _____, Recorded Plat _____
- 5. Private Claims _____

I, Huston K. Kennedy, in a field survey on August 10, 19 94, do hereby certify that under requirements of P.A. 74, Michigan P.A. of 1970, the corner points mentioned in lines 1 and 2 above were in conformance with regulations and rules therefore as required in the current manual of survey instructions of the United States Department of the Interior, Bureau of Land Management or by a decree of a Court of Law and/or that the corner points mentioned in lines 3, 4 and 5 above were in conformance with the rules of the Michigan Board of Land Surveyors or by a Decree of a Court of Law; established, re-established, monumented, re-monumented, recovered, found as expressed below:

NOTE: Not more than 4 corners, all in the same town and range, may be recorded on this certificate.

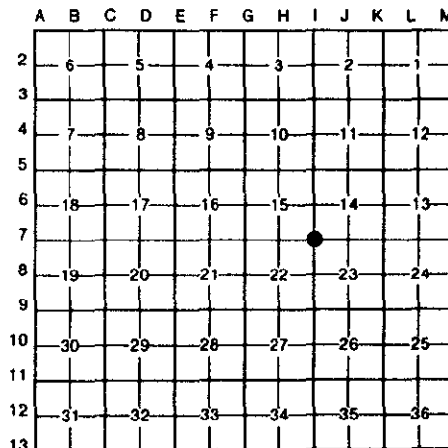

A. Description of original monument and accessories and/or subsequent restoration:

- 1818-GLO Wampler, D.S.; Set Post; 34" White Oak S84*W 43 Links; 12" White Oak N53*E 4 Links
- 1.) 1979-Buckerfield, P.S. #10868; LCRC L.7508, Pg.677 - Fnd 1/2" Rod
- 2.) 1980-Heil, P.S. #18993; LCRC L.7739, Pg.895 - Fnd 1/2" Iron Rod
- 3.) 1982-Henderson, P.S. #16043; LCRC L.8153, Pg.440 - Fnd 1/2" Iron Rod
- 4.) 1982-Henderson, P.S. #16043; Survey L.8153, Pg.439 - Fnd 1/2" Iron Rod, used same wit as 1982 LCRC
- 5.) 1985-Sandomierski, P.S. #24616; Unrecorded Survey - Fnd 1/2" Iron Rod
- 6.) 1992-Kennedy, P.S. #17623; Unrecorded Survey - Fnd 1/2" Iron Rod in a Monument Box

B. Description of corner evidence found and/or method applied in restoring or reestablishing corner:

1994 Kennedy Surveying, Inc. - Kennedy, P.S. #17623 - Fnd 1/2" Iron rod located in the centerline of Oxford Road to the South, which is bituminous surface, and in the centerline of Ray Road, which is bituminous surface to the East and gravel surface to the West.

Witnesses from LCRC #1, 2 & 3 were used to recover and verify the location of the found 1/2" Iron Rod.

I accepted the found 1/2" Iron Rod as the best evidence of the original corner position.

C. Description of monument for corner and accessories established to perpetuate locating the position of the corner:

- I-7 I replaced the found 1/2" Iron Rod with a 5/8" x 24" Iron Rod w/2" diameter brass cap stamped Oakland County Remonumentation, PS #17623 in a new Monument Box.
- S76°W 127.91' Set PK & Remon. Washer North face 12" Oak
- N04°E 50.17' Set PK & Remon. Washer West face Power Pole
- N72°W 123.61' Set PK & Remon. Washer South face 15" Oak
- S31°W 39.80' Set PK & Remon. Washer SE face 15" Oak

The selected location is accepted by me and is generally accepted by Professional Surveyors as the best available evidence of the position of the original corner.

Signed by Huston K. Kennedy
Surveyor's Michigan License No. 17623

Date October 10, 1994

