

MAY 16 1996

COMMISSION

LIBER 15282 pg 107

LAND CORNER RECORDATION CERTIFICATE

Filing Requirement of Act 74, Mich. P.A. 1979 9.00

MAR 795038109 COPY

For corners in Oakland (County)

Located In: Oxford Twp., Corner Code # I-9

- 1. Public Land Survey T 5N R 10E
2. Property Controlling in Section S T R
3. Miscellaneous Property in Sec. S T R
4. Lot No. Recorded Plat
5. Private Claims

MISCELLANEOUS RECORDING \$ 2.00 REMONUMENTATION 7 MAR 95 4:07 P.M. RECEIPT# 217B PAID RECORDED - OAKLAND COUNTY LYNN D. ALLEN, CLERK/REGISTER OF DEEDS

Compliance with ACT 345, P.A. 1990

APPROVED ON: 12-07-94 OAKLAND COUNTY REMONUMENTATION PEER GROUP COMMITTEE Register of Deeds Stamp & File Number

I, Huston K. Kennedy, in a field survey on December 20, 1994, do hereby certify that under requirements of P.A. 74, Michigan P.A. of 1970, the corner points mentioned in lines 1 and 2 above were in conformance with regulations and rules therefore as required in the current manual of survey instructions of the United States Department of the Interior, Bureau of Land Management or by a decree of a Court of Law and/or that the corner points mentioned in lines 3, 4 and 5 above were in conformance with the rules of the Michigan Board of Land Surveyors or by a Decree of a Court of Law, established, re-established, monumented, re-monumented, recovered, found as expressed below:

NOTE: Not more than 4 corners, all in the same town and range, may be recorded on this certificate.

A. Description of original monument and accessories and/or subsequent restoration:

- 1817-GLO Wampler, D.S.; Set Post 12" White Oak S50°E 71 Links; 10" White Oak N74°W 112 Links
1.) 1977-Kennedy, P.S. #17623; L.7037, Pg.886 - Fnd?
2.) 1975-Johnson & Anderson, Inc. Survey L.8631, Pg? - Fnd P.K. Nail
3.) 1982-Henderson, P.S. #16043; Survey L.8153, Pg.437 - Fnd Manhole
4.) 1985-Kennedy, P.S. #17623; Survey L.8908, Pg.554 - Falls on manhole cover
5.) 1977-Kennedy, P.S. #17623; Unrecorded Survey - Falls on manhole cover
6.) 1977-Kennedy, P.S. #17623; Unrecorded Survey - Falls on manhole cover, used same wit as 1977 Unrecorded Survey

B. Description of corner evidence found and/or method applied in restoring or reestablishing corner:

1994 Kennedy Surveying, Inc. - Kennedy, P.S. #17623 - Recovered the corner storm sewer manhole cover, which is located in the intersection of Burdick & Glaspie Streets. Burdick and Glaspie Streets both have bituminous surface. Based upon the witnesses the tip of "A" in the word "Jordan" in the line "East Jordan Michigan USA" is being accepted and used?

Witnesses from LCRC #1, Survey #2 were used to recover and verify the location of the tip of "A" in the word "Jordan" in the line "East Jordan Michigan USA" on the storm sewer manhole cover.

I accept the the tip of "A" in the word "Jordan" in the line "East Jordan Michigan USA" on the storm sewer manhole cover as the best evidence of the original corner position.

FIELD MEASUREMENTS BETWEEN

- I-9 to H-9 2468.55 Ft. (H. Kennedy 1994)
I-9 to J-9 2772.23 Ft. (H. Kennedy 1991)
I-9 to J-8 3151.78 Ft. (H. Kennedy 1977)

C. Description of monument for corner and accessories established to perpetuate locating the position of the corner:

I-9 I accept the the tip of "A" in the word "Jordan" in the line "East Jordan Michigan USA" as the corner based upon the existing witnesses.

- S29°E 61.18' Set PK & Remon. Washer NE face Power Pole
N15°E 97.94' Set PK & Remon. Washer NW face Power Pole
N30°W 48.32' Set PK & Remon. Washer SW face Power Pole
S32°W 42.97' Set PK & Remon. Washer SE face Guide Pole
North 100.00' set 5/8" x 24" Iron Rod in a Monument Box (See back side for accessory corner to I-9)


The selected location is accepted by me and is generally accepted by Professional Surveyors as the best available evidence of the position of the original corner.



Signed by [Signature]

Date January 23, 1995

Surveyor's Michigan License No. 17623

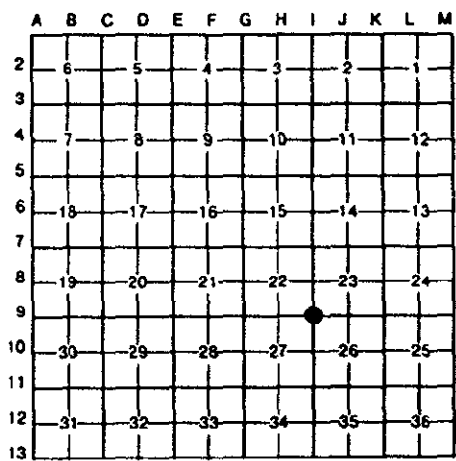

[Handwritten signature]

[Handwritten signature]