COPY

LIBER 15517 PG 408

JUL 14 95 12 52 40

LAND CORNER RECORDATION CERTIFICATE

Filing Requirement of Act 74, Mich. P.A. 1970

For corners in Oakland (County)

Located In: Oxford Twp. Corner Code #

$ 7.00 MISCELLANEOUS RECORDING
$ 2.00 REMONUMENTATION
14 JUL 95 8:37 A.M. RECEIPT# 9B
PAID RECORDED - OAKLAND COUNTY
LYNN D. ALLEN, CLERK/REGISTER OF DEEDS

Compliance with ACT 345, P.A. 1990

APPROVED ON: 6-14-95 Tom S
OAKLAND COUNTY REMONUMENTATION PEER GROUP COMMITTEE

Register of Deeds Stamp & File Number

1. Public Land Survey		T 5 N	R 10 E	I-10
		T ____	R ____	
		T ____	R ____	
		T ____	R ____	
2. Property Controlling	S ____	T ____	R ____	
in Section	S ____	T ____	R ____	
3. Miscellaneous	S ____	T ____	R ____	
Property in Section	S ____	T ____	R ____	

4. Lot No. _____, Recorded Plat _____
5. Private Claims _____

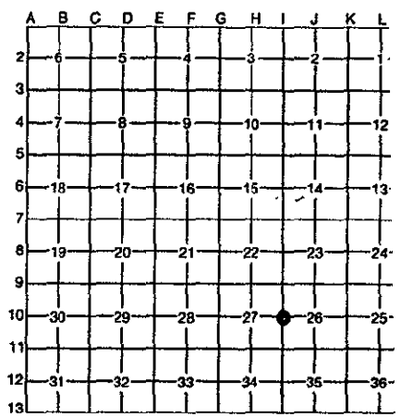

I, Huston K. Kennedy, in a field survey on April 26, 19 95, do hereby certify that under requirements of P.A. 74, Michigan P.A. of 1970, the corner points mentioned in lines 1 and 2 above were in conformance with regulations and rules therefore as required in the current manual of survey instructions of the United States Department of the Interior, Bureau of Land Management or by a decree of a Court of Law and/or that the corner points mentioned in lines 3, 4 and 5 above were in conformance with the rules of the Michigan Board of Professional Surveyors or by a Decree of a Court of Law; established, re-established, monumented, re-monumented, recovered, found as expressed below:

NOTE: Not more than 4 corners, all in the same town and range, may be recorded on this certificate.

A. Description of original monument and accessories and/or subsequent restoration:

1818-GLO Wampler, D.S.; Set Post 12" White Oak S16°E 21 Links; 10" Black Oak N19°W 142 Links
1.) Balley, PS #33968; Unrecorded Survey - Building falls within the corner

B. Description of corner evidence found and/or method applied in restoring or reestablishing corner:

1995 Kennedy Surveying, Inc. - Kennedy, PS #17623 - Fnd Corner now falls within a building.

I set a point on a projected line from I-11 thru the Northeast corner of Lot 60 of said "MINNETONKA DRIVE SUBDIVISION" 83.50 feet South of I-10.

FIELD MEASUREMENTS BETWEEN

I-11 to I-10 2630.80 Ft., GLO = 40 chains or 2640.00 Ft.

7.00
2.00 Rem

C. Description of monument for corner and accessories established to perpetuate locating the position of the corner:

I set a 1/2" Iron Rod encased in a 4" diameter concrete cylinder 36" long w/2" diameter brass cap stamped Oakland County Remonumentation, PS #17623, 83.50 feet South of J-10 as a reference corner
S12°E 68.51' Set PK & Remon. Washer SW face Power Pole
S31°W 119.42' NE corner of garage of house #55
N82°E 74.21' Set PK & Remon. Washer SW face Power Pole
N27°W 40.73' SW corner of bank

The selected location for this reference corner is accepted as a careful and faithful determination of the position as indicated.

Signed by _____ Date June 15, 1995

Surveyor's Michigan License No. 17623

STATE OF MICHIGAN
HUSTON KENNEDY
PROFESSIONAL SURVEYOR
17623
LICENSED PROFESSIONAL SURVEYOR

FORM APPROVED BY MICHIGAN STATE BOARD OF PROFESSIONAL SURVEYORS, JAN. 1970 REVISED MAY 1973 REVISED JAN. 1983