

LAND CORNER RECORDATION CERTIFICATE

Filing Requirement of Act 74, Mich. P.A. 1970 \$ 7.00 MISCELLANEOUS RECORDING

For corners in Oakland (County)

Located in: Oxford Twp. Corner Code #

\$ 2.00 REMONUMENTATION
14 JUL 95 8:58 A.M. RECEIPT# 98
PAID RECORDED - OAKLAND COUNTY
LYNN D. ALLEN, CLERK/REGISTER OF DEEDS

Table with 3 columns: Survey Description, Corner Code (T, S, R, I), and Value (5N, 10E, I-11)

Compliance with ACT 345, P.A. 1990

APPROVED ON: 6-14-95 Tom S
OAKLAND COUNTY REMONUMENTATION
PEER GROUP COMMITTEE
Register of Deeds Stamp & File Number

4. Lot No. Recorded Plat
5. Private Claims

I, Huston K. Kennedy in a field survey on April 26, 1995, do hereby certify that under requirements of P.A. 74, Michigan P.A. of 1970, the corner points mentioned in lines 1 and 2 above were in conformance with regulations and rules therefore as required in the current manual of survey instructions of the United States Department of the Interior, Bureau of Land Management or by a decree of a Court of Law and/or that the corner points mentioned in lines 3, 4 and 5 above were in conformance with the rules of the Michigan Board of Professional Surveyors or by a Decree of a Court of Law; established, re-established, monumented, re-monumented, recovered, found as expressed below:

NOTE: Not more than 4 corners, all in the same town and range, may be recorded on this certificate.

A. Description of original monument and accessories and/or subsequent restoration:

- 1817-GLO Wampler, D.S.; Set Post 15" White Oak N29°E 28 Links; 15" White Oak S33°W 66 Links
1.) 1973-Lester, PS #18998; LCRC L.6028, Pg.841 - Set 1/2" Bar
2.) 1973-Buckerfield, PS #10868; L.6196, Pg.452 - Fnd 1" Iron Pipe
3.) 1976-Kennedy, PS #17623; L.6821, Pg.468 - Fnd 1/2" Iron Pin
4.) 1981-Kobs, PS #14097; LCRC L.8113, Pg.60 - Fnd 1/2" Iron Bar
5.) 1981-Kobs, PS #14097; Survey L.8113, Pg.63 - Fnd 1/2" Iron Bar in a Monument Box, used same wit as 1981 LCRC
6.) 1984-Kennedy, PS #17623; Survey L.8809, Pg.448 - Fnd 1/2" Iron Rod, used same wit as 1976 LCRC

B. Description of corner evidence found and/or method applied in restoring or reestablishing corner:

1995 Kennedy Surveying, Inc. - Kennedy, PS #17623 - Fnd 1/2" Iron Rod 3.5 feet South of the centerline of Drahner Road extending to the East & West, which has a bituminous surface. A tree row extending to the North & South.

Witnesses from LCRC #1, 3 & 4 were used to recover and verify the location of the found 1/2" Iron Rod.

I accepted the found 1/2" Iron Rod as the best evidence of the original corner position.

FIELD MEASUREMENTS BETWEEN

- I-11 to H-11 2207.47 Ft., GLO = 39.95 chains or 2636.70 Ft.
I-11 to J-11 2811.72 Ft., GLO = 40 chains or 2640.00 Ft.
I-11 to I-10 2630.80 Ft., GLO = 40 chains or 2640.00 Ft.
I-11 to I-12 2407.47 Ft., GLO = 40 chains or 2640.00 Ft.


C. Description of monument for corner and accessories established to perpetuate locating the position of the corner:

- I-11 I replaced the found 1/2" Iron Rod with a 5/8" x 24" Iron Rod w/2" diameter brass cap stamped Oakland County Remonumentation PS #17623 in a new Monument Box.
N48°E 48.50' Set PK & Remon. Washer NW face Power Pole
N67°W 91.90' Set PK & Remon. Washer SW face Power Pole
S66°W 91.02' Set PK & Remon. Washer NW face Power Pole
S03°E 53.60' Set PK & Remon. Washer SE face 23" Oak

The selected location is accepted by me and is generally accepted by Professional Surveyors as the best available evidence position of the original corner.

Signed by [Signature]
Surveyor's Michigan License No. 17623

Date June 14, 1995

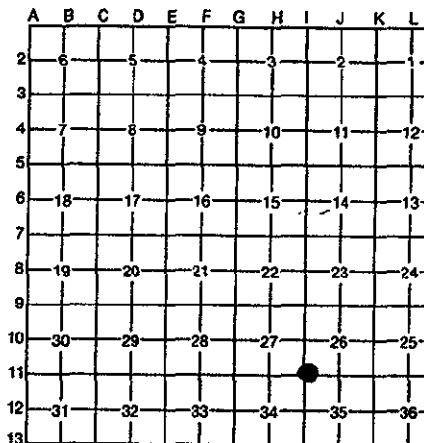

7.00
2.00 LCW