

LAND CORNER RECORDATION CERTIFICATE

Filing Requirement of Act 74, Mich. P.A. 1970

OK - T. SMITH

For corners in
Oakland
(County)

Located in: Oxford
Township Corner Code # J-1

\$ 7.00 MISCELLANEOUS RECORDING
\$ 2.00 REMONUMENTATION
8 SEP 94 3:19 P.M. RECEIPT# 134E
PAID RECORDED - OAKLAND COUNT
LYNN D. ALLEN, CLERK/REGISTER OF DEED

Compliance with
ACT 345, P.A. 1990

APPROVED ON: 1-5-94
OAKLAND COUNTY REMONUMENTATIO
PEER GROUP COMMITTEE
Register of Deeds Stamp & File Number

Table with 3 columns: Item description, Township (T/S), Range (R), and Corner Code. Includes items for Public Land Survey, Property Controlling in Section, and Miscellaneous Property in Sec.

4. Lot No. , Recorded Plat
5. Private Claims

I, Huston K. Kennedy, in a field survey on November 4, 1993, do hereby certify that under requirements of P.A. 74, Michigan P.A. of 1970, the corner points mentioned in lines 1 and 2 above were in conformance with regulations and rules therefore as required in the current manual of survey instructions of the United States Department of the Interior, Bureau of Land Management or by a decree of a Court of Law and/or that the corner points mentioned in lines 3, 4 and 5 above were in conformance with the rules of the Michigan Board of Land Surveyors or by a Decree of a Court of Law; established, re-established, monumented, re-monumented, recovered, found as expressed below:

Grid table with columns A-L and rows 2-13. A dot is marked in the intersection of column J and row 2.

NOTE: Not more than 4 corners, all in the same town and range, may be recorded on this certificate.

A. Description of original monument and accessories and/or subsequent restoration:

- 1817 GLO - Wampler, D.S.; Post set; No witnesses
1982 Kennedy, P.S. #17623; LCRC L.8132, Pg.544 - Fnd 1/2" iron rod
1986 Gravlin, P.S. #23510; Survey L.9373, Pg.155-156 - Fnd 1/2" iron rod

Handwritten signature/initials.

B. Description of corner evidence found and/or method applied in restoring or reestablishing corner:

1993 Kennedy Surveying, Inc. - Huston Kennedy, P.S. #17623 - Fnd 1/2" iron rod 2' North of the center of Davison Lake Road, and the center of Gardner Road to the South, which is abandoned. Both are gravel roads. The witness trees are still existing, but the witness points are grown over. The witness trees were used to recover and verify the found 1/2" iron rod.


I accepted the fnd 1/2" iron rod as the best evidence of the original corner position.

C. Description of monument for corner and accessories established to perpetuate locating the position of the corner:

J-1 I replaced the found 1/2" iron rod with a 5/8" x 24" iron rod with a 2" diameter cap stamped Oakland County Remonumentation P.S. #17623.

- N33°E-30.68 ft-Set PK/Remon. Tag East face 18" Cherry
N63°W-29.38 ft-Set PK/Remon. Tag NE face 23" Oak
S64°W-37.21 ft-Set PK/Remon. Tag North face 13" Poplar
S41°E-37.95 ft-Set PK/Remon. Tag SW face 18" Cherry

The selected location is accepted by me and is generally accepted by Professional Surveyors as the best available evidence of the position of the original position.

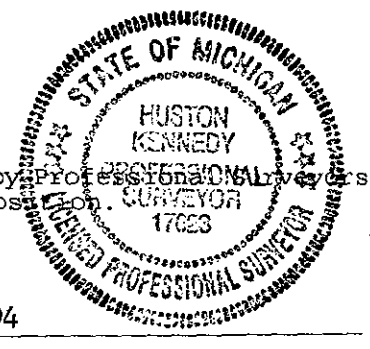

Signed by [Signature]
Surveyor's Michigan License No.

Date March 23, 1994