

LAND CORNER RECORDATION CERTIFICATE
Filing Requirement of Act 74, Mich. P.A. 1970

For corners in

Oakland (County)

Located In: Oxford Township Corner Code -#

Table with 3 columns: Survey Type, Township/Range/Section, and Corner Code. Includes entries for Public Land Survey, Property Controlling in Section, and Miscellaneous Property in Sec.

4. Lot No. , Recorded Plat
5. Private Claims

OK - T. SMITH
\$ 7.00 MISCELLANEOUS RECORDING
\$ 2.00 REMONUMENTATION
8 SEP 94 3:20 P.M. RECEIPT# 1348
PAID RECORDED - OAKLAND COUNTY
LYNN D. ALLEN, CLERK/REGISTER OF DEEDS
Compliance with ACT 345, P.A. 1990

APPROVED ON: 12-29-93
OAKLAND COUNTY REMONUMENTATION
PBER GROUP COMMITTEE
Register of Deeds Stamp & File Number

I, Huston K. Kennedy, in a field survey on November 4, 1993, do hereby certify that under requirements of P.A. 74, Michigan P.A. of 1970, the corner points mentioned in lines 1 and 2 above were in conformance with regulations and rules therefore as required in the current manual of survey instructions of the United States Department of the Interior, Bureau of Land Management or by a decree of a Court of Law and/or that the corner points mentioned in lines 3, 4 and 5 above were in conformance with the rules of the Michigan Board of Land Surveyors or by a Decree of a Court of Law; established, re-established, monumented, re-monumented, recovered, found as expressed below:

NOTE: Not more than 4 corners, all in the same town and range, may be recorded on this certificate.

A. Description of original monument and accessories and/or subsequent restoration:

- 1817 GLO - Wampler, D.S.; Set post; 18" White Oak N59°E 0.67 lks.
1972 Henderson, P.S. #16043; LCRC L.5971, Pg.23-24 - Fnd 3/4" iron pipe
1986 Reichert, P.S. #30099; Survey L.9457, Pg.549-550 - Same wits as 1972 LCRC
1992 Kennedy, P.S. #17623; LCRC L.12869, Pg.826 - Fnd 3/4" iron pipe

B. Description of corner evidence found and/or method applied in restoring or reestablishing corner:

1993 Kennedy Surveying, Inc. - Huston Kennedy, P.S. #17623 - Fnd 3/4" iron pipe at the intersection of Oakwood Road and Gardner Road to the North, and 3' West of center of Gardner Road to the South. Both are gravel roads. The witness points from the 1992 LCRC still exist. They were used to recover and verify the found 3/4" iron pipe.


I accepted the found 3/4" iron pipe as the best evidence of the original corner position.

C. Description of monument for corner and accessories established to perpetuate locating the position of the corner:

J-3 I replaced the found 3/4" iron rod with a 5/8" x 24" iron rod with a 2" diameter cap stamped Oakland County Remonumentation P.S. #17623.

- N67°W-64.16 ft-Set PK/Remon. Tag SW face 18" Oak
N48°W-34.11 ft-Set PK/Remon. Tag SW face 40" Oak
N61°E-63.95 ft-Set PK/Remon. Tag NE face 12" Ash
S34°E-52.27 ft-Set PK/Remon. Tag West face 15" & 17" Twin Ash

The selected location is accepted by me and is generally accepted by the profession as the best available evidence of the position of the original position.

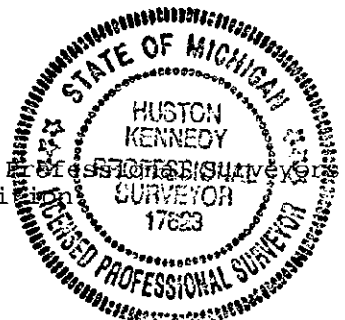

Signed by [Signature]
Surveyor's Michigan License No. 17623

Date March 23, 1994