

LAND CORNER RECORDATION CERTIFICATE

Filing Requirement of Act 74, Mich. P.A. 1970

\$ 7.00 MISCELLANEOUS RECORDING

\$ 2.00 REMONUMENTATION

14 JUL 95 8:38 A.M. RECEIPT# 9B PAID RECORDED - OAKLAND COUNTY LYNN D. ALLEN, CLERK/REGISTER OF DEEDS

For corners in Oakland (County)


Located In: Oxford Twp. Corner Code #

Table with 4 columns: Item description, T/S, R/E, and Corner Code. Includes items like Public Land Survey, Property Controlling in Section, and Miscellaneous Property in Section.

Compliance with ACT 345, P.A. 1990

APPROVED ON: 6-14-95 Tom S OAKLAND COUNTY REMONUMENTATION PEER GROUP COMMITTEE Register of Deeds Stamp & File Number

4. Lot No. Recorded Plat
5. Private Claims

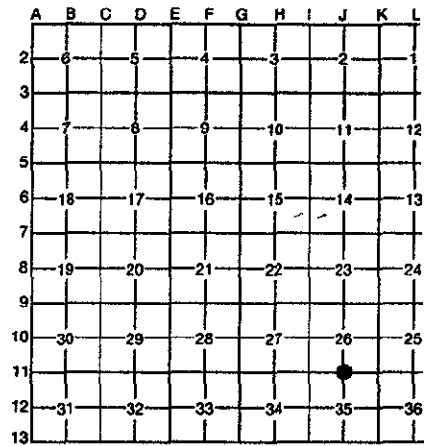

I, Huston K. Kennedy, in a field survey on April 26, 1995, do hereby certify that under requirements of P.A. 74, Michigan P.A. of 1970, the corner points mentioned in lines 1 and 2 above were in conformance with regulations and rules therefore as required in the current manual of survey instructions of the United States Department of the Interior, Bureau of Land Management or by a decree of a Court of Law and/or that the corner points mentioned in lines 3, 4 and 5 above were in conformance with the rules of the Michigan Board of Professional Surveyors or by a Decree of a Court of Law; established, re-established, monumented, re-monumented, recovered, found as expressed below:

NOTE: Not more than 4 corners, all in the same town and range, may be recorded on this certificate.

A. Description of original monument and accessories and/or subsequent restoration:

- 1818-GLO Wampler, D.S.; Corner Not Set, Marsh Land
1.) 1973-Buckerfield, PS #10868; LCRC L.6260, Pg.658 - Fnd 1/2" Iron Bar
2.) 1981-Kobs, PS #14097; LCRC L.8113, Pg.60 - Fnd 1/2" Boat Spike in a Monument Box
3.) 1992-Neil, PS #18993; LCRC L.12375, Pg.118 - Fnd 1/2" Steel Rod in well
4.) 1981-Kobs, PS #14097; Survey L.8113, Pg.63 - Fnd 1/2" Boat Spike in Monument Box, used same wit as 1981 LCRC
5.) 1984-Kennedy, PS #17623; Survey L.8809, Pg.448 - Fnd 1/2" Iron Rod in a Monument Box
6.) 1976-Kennedy, PS #17623; Unrecorded Survey - Fnd 1" Iron in a Monument Box
7.) 1982-Kennedy, PS #17623; Unrecorded Survey - Fnd 1" Iron in a Monument Box used same wit as 1976 Unrecorded Survey

B. Description of corner evidence found and/or method applied in restoring or reestablishing corner:

1995 Kennedy Surveying, Inc. - Kennedy, PS #17623 - Fnd 1/2" Iron Rod in a Monument Box 1 foot North of Drahner Road extending to the East & West, which has a bituminous surface, and 40 feet East of Oxford Lakes Drive extending to the North, which has a bituminous surface.

Witnesses from LCRC #1, 2 & 3 Survey #5 and Unrecorded Survey #6 were used to recover and verify the location of the found 1/2" Iron Rod in a Monument Box.

I accepted the found 1/2" Iron Rod in a Monument Box as the best evidence of the original corner position.

FIELD MEASUREMENTS BETWEEN

J-11 to I-11 2811.72 Ft., GLO = 40 chains or 2640.00 Ft.
J-11 to K-11 2769.19 Ft., GLO = 40 chains or 2640.00 Ft.

C. Description of monument for corner and accessories established to perpetuate locating the position of the corner:

- J-11 I replaced the found 1/2" Iron Rod with a 5/8" x 24" Iron Rod w/2" diameter brass cap stamped Oakland County Remonumentation PS #17623 in a existing Monument Box
N44°W 78.42' Set PK & Remon. Washer SW face Power Pole
N83°W 185.20' Set PK & Remon. Washer South face Power Pole
N22°E 62.52' Set PK & Remon. Washer NW face 12" twin Pine
N84°E 165.91' Set PK & Remon. Washer South face Power Pole

The selected location is accepted by me and is generally accepted by Professional Surveyors as the best available evidence of position of the original corner.

Signed by [Signature]
Surveyor's Michigan License No. 17623

Date June 14, 1995

