

COPY

LIBER 15517rc412

JUL 14 95 12524

LAND CORNER RECORDATION CERTIFICATE

Filing Requirement of Act 74, Mich. P.A. 1970

For corners in Oakland (County)

Located In: Oxford Twp. Corner Code #

\$ 7.00 MISCELLANEOUS RECORDING
\$ 2.00 REMONUMENTATION
14 JUL 95 8:38 A.M. RECEIPT# 9B
PAID RECORDED - OAKLAND COUNTY
LYNN D. ALLEN, CLERK/REGISTER OF DEEDS

Table with 4 columns: Item, T, R, and Code. Row 1: Public Land Survey, T 5N R 10E, J-13. Row 2: Property Controlling in Section, S T R. Row 3: Miscellaneous Property in Section, S T R.

Compliance with ACT 345, P.A. 1990
APPROVED ON: 6-14-95 TMS
OAKLAND COUNTY REMONUMENTATION PEER GROUP COMMITTEE
Register of Deeds Stamp & File Number

4. Lot No. Recorded Plat
5. Private Claims

Grid table with columns A-L and rows 1-13. A dot is marked in the intersection of column J and row 13.

Huston K. Kennedy, in a field survey on April 26, 1995, do hereby certify that under requirements of P.A. 74, Michigan P.A. of 1970, the corner points mentioned in lines 1 and 2 above were in conformance with regulations and rules therefore as required in the current manual of survey instructions of the United States Department of the Interior, Bureau of Land Management or by a decree of a Court of Law and/or that the corner points mentioned in lines 3, 4 and 5 above were in conformance with the rules of the Michigan Board of Professional Surveyors or by a Decree of a Court of Law; established, re-established, monumented, re-monumented, recovered, found as expressed below:

NOTE: Not more than 4 corners, all in the same town and range, may be recorded on this certificate.

A. Description of original monument and accessories and/or subsequent restoration:

- 1818-GLO Wampler, D.S.; Set Post 7" Tamarack #01'E 61 Links
1.) 1975-Neil, PS #18993; LCRC L.6587, Pg.363 - Fnd Iron Rod in well
2.) 1995-Kennedy, PS #17623; Unrecorded Survey - Fnd 1/2" Iron Rod in a Monument Box

B. Description of corner evidence found and/or method applied in restoring or reestablishing corner:

1995 Kennedy Surveying, Inc. - Kennedy, PS #17623 - Fnd 1/2" Iron Rod in a Monument Box 2 feet off the East edge of the North bound lane of M-24 Highway extending to the North & South, which has a bituminous surface, and in the centerline of Indian Lake Road extending to the East, with a gravel surface. This corner is also being accepted and used as a common corner with the North 1/4 corner of Section 2, T4N, R10E, Orion Twp. (J-1)

Witnesses from LCRC #1 were used to recover and verify the location of the found 1/2" Iron Rod in a Monument Box.

I accepted the found 1/2" Iron Rod in a Monument Box as the best evidence of the original corner position.

FIELD MEASUREMENTS BETWEEN

J-13 to K-13 2612.84 Ft., GLO = 40 chains or 2640.00 Ft.


C. Description of monument for corner and accessories established to perpetuate locating the position of the corner:

- J-13-I replaced the found 1/2" Iron Rod with a 5/8" x 24" Iron Rod w/2" diameter brass cap stamped Oakland County Remonumentation PS #17623 in a existing Monument Box.
N61°W 153.36' Set PK & Remon. Washer SE face Power Pole
N74°E 48.41' Set PK & Remon. Washer NW face Power Pole
S64°W 124.73' Set PK & Remon. Washer SE face Guide Pole
S64°E 51.75' Chiseled X in concrete wall SW corner

The selected location is accepted by me and is generally accepted by Professional Surveyors as the best available evidence of the position of the original corner.

Signed by [Signature]
Surveyor's Michigan License No. 17623

Date June 14, 1995

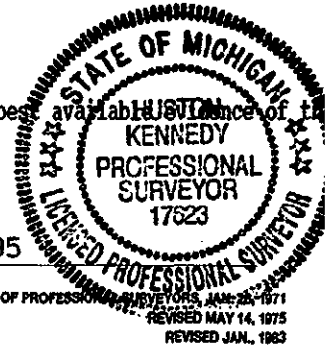

7.00
2.00 amt