

LAND CORNER RECORDATION CERTIFICATE
Filing Requirement of Act 74, Mich. P.A. 1970

OK - T. SMITH

For comers in

Oakland

(County)

Located In: Oxford Township

Corner Code #

1. Public Land Survey

T 5 N R 10 E K-3

T R

T R

T R

2. Property Controlling in Section

S T R

S T R

3. Miscellaneous Property in Sec.

S T R

S T R

4. Lot No. , Recorded Plat

5. Private Claims

\$ 7.00 MISCELLANEOUS RECORDING
\$ 2.00 REMONUMENTATION
8 SEP 94 3:20 P.M. RECEIPT# 134B
PAID RECORDED - OAKLAND COUNTY
LYNN D. ALLEN, CLERK/REGISTER OF DEEDS

Compliance with ACT 345, P.A. 1990

APPROVED ON: 1-5-94
OAKLAND COUNTY REMONUMENTATION
PEER GROUP COMMITTEE
Register of Deeds Stamp & File Number

I, Huston K. Kennedy, in a field survey on November 4, 1993

do hereby certify that under requirements of P.A. 74, Michigan P.A. of 1970, the corner points mentioned in lines 1 and 2 above were in conformance with regulations and rules therefore as required in the current manual of survey instructions of the United States Department of the Interior, Bureau of Land Management or by a decree of a Court of Law and/or that the corner points mentioned in lines 3, 4 and 5 above were in conformance with the rules of the Michigan Board of Land Surveyors or by a Decree of a Court of Law; established, re-established, monumented, re-monumented, recovered, found as expressed below;

NOTE: Not more than 4 corners, all in the same town and range, may be recorded on this certificate.

A. Description of original monument and accessories and/or subsequent restoration:

1817 GLO - Wampler, D.S.; Post set; 18" White Oak S63°W 1.02 chains,
15" White Oak N77°E 0.30 lks.
1982 Kennedy, P.S. #17623; LCRC L.8256, Pg.502 - Fnd 1/2" iron rod

B. Description of corner evidence found and/or method applied in restoring or reestablishing corner:

1993 Kennedy Surveying, Inc. - Huston Kennedy, P.S. #17623 - Fnd 1/2" iron rod in the center of the intersection of Oakwood Road and Barber Road to the North. Both are gravel roads. The power poles still exist. They were used to recover and verify the found 1/2" iron rod.

I accepted the found 1/2" iron rod as the best evidence of the original corner location.

C. Description of monument for corner and accessories established to perpetuate locating the position of the corner:


K-3 I replaced the found 1/2" iron rod with a 5/8" x 24" iron rod with a 2" diameter cap stamped Oakland County Remonumentation P.S. #17623.

N44°E-41.98 ft-Set PK/Remon. Tag SE face Power Pole
N21°W-70.29 ft-Set PK/Remon. Tag East face 29" Oak
N64°W-73.14 ft-Set PK/Remon. Tag SW face 12" Ash
S59°W-51.07 ft-Set PK/Remon. Tag North face 28" Oak

The selected location is accepted by me and is generally accepted by Professional Surveyors as the best available evidence of the position of the original position. 17623

Signed by [Signature]
Surveyor's Michigan License No. 17623

Date March 23, 1994

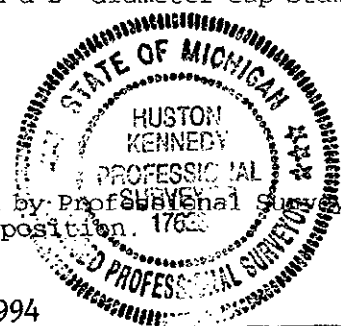

Grid table with columns A-L and rows 2-13. A dot is marked at row 3, column J.

[Handwritten signature]