

**SURVEY &
REMONUMENTATION**

LIBER **14833** Pg. **157**

94 **193401**

MAY - 1 1995

LAND CORNER RECORDATION CERTIFICATE
Filing Requirement of Act 74, Mich. P.A. 1970

Compliance with
ACT 345, P.A. 1990

For corners in **COMMISSION**

APPROVED ON: 7-11-94
OAKLAND COUNTY REMONUMENTAT
PEER GROUP COMMITTEE

Oakland (County)	Located In:	Corner Code #
1. Public Land Survey	T 5N R 11E	A-1
	T R	
	T R	
	T R	
2. Property Controlling in Section	S T R	
	S T R	
3. Miscellaneous Property in Sec.	S T R	
	S T R	
4. Lot No. _____, Recorded Plat _____		
5. Private Claims _____		

\$ -7.00 MISCELLANEOUS RECORDING
\$ 2.00 REMONUMENTATION
15 JUL 94 7:38 A.M. RECEIPT# 1A
PAID RECORDED - OAKLAND COUNTY
LYNN D. ALLEN, CLERK/REGISTER OF DEEDS
OK - T. SMITH
Register of Deeds Stamp & File Number

I, Bruce Antcliff, in a field survey on November 16, 19 93, do hereby certify that under requirements of P.A. 74, Michigan P.A. of 1970, the corner points mentioned in lines 1 and 2 above were in conformance with regulations and rules therefore as required in the current manual of survey instructions of the United States Department of the Interior, Bureau of Land Management or by a decree of a Court of Law and/or that the corner points mentioned in lines 3, 4 and 5 above were in conformance with the rules of the Michigan Board of Land Surveyors or by a Decree of a Court of Law, established, re-established, monumented, re-monumented, recovered, found as expressed below:

NOTE: Not more than 4 corners, all in the same town and range, may be recorded on this certificate.

A. Description of original monument and accessories and/or subsequent restoration:

A-1	GLO Post	Oakland County Iron Pipe 12" Hickory SW 91.0	Survey L. 5905, P. 760 (1972) 1/2" Iron 6" Ash N 15° E 92.81' 14" Twin Oak N 70° E 55.53' D.E. Pole S 70° E 35.11'
-----	-------------	--	--

B. Description of corner evidence found and/or method applied in restoring or reestablishing corner:

A-1 Found 4" concrete monument at intersection of gravel roads running north and west on fence line running east, measure South 2,836.5' ± to W 1/4 Corner Section 6. This checks closely dist. shown on Survey L. 5905, P. 760 (2,835.45').
Checks the following witnesses:


P. Pole East - 29.98'	14" Twin Oak N 70° E 55.53'
Twin 15" Oak S 50° E - 34.48'	
4" Ash N 50° W - 51.40'	

C. Description of monument for corner and accessories established to perpetuate locating the position of the corner:

A-1 The selected location is accepted by the Contractor and is generally accepted by professional surveyors as the best available evidence of the position of the original corner.

Set standard Oakland County cap on existing concrete monument.

P.K. Nail and Brass Tag in S.E. Face 18" Oak N 57° E - 33.66'
P.K. Nail and Brass Tag in E. Face 10" Ash N 05° W - 90.98'
P.K. Nail and Brass Tag in N. Face 12" Cherry - N 50° W - 68.97'
P.K. Nail and Brass Tag in S. Side of Pole East - 29.98'

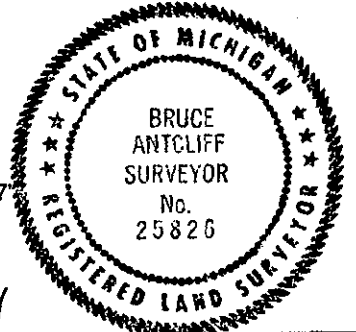

Signed by Bruce Antcliff Date 7-11-94

Surveyor's Michigan License No. 25826