

SURVEY & REMONUMENTATION

MAY - 1 1995

LIBR 15234 PG 523

FEB 29 5 01 9970

OK - T. SMITH

LAND CORNER RECORDATION CERTIFICATE
 Filing Requirement of Act 74, Mich. P.A. 1970

For corners in

COMMISSION


7.00 MISCELLANEOUS RECORDING
 \$ 2.00 REMONUMENTATION
 2 FEB 95 7:21 A.M. RECEIPT# 28
 PAID RECORDED - OAKLAND COUNTY
 LYNN D. ALLEN, CLERK/REGISTER OF DEEDS

Compliance with
 ACT 345, P.A. 1990

APPROVED ON: 12-12-94
 OAKLAND COUNTY REMONUMENTATION
 PEER GROUP COMMITTEE

Register of Deeds Stamp & File Number

For corners in	Located in:	Addison Township	Corner Code #
<u>Oakland</u> (County)			
1. Public Land Survey	T <u>5N</u> R <u>11E</u>		<u>A-6</u>
	T _____ R _____		_____
	T _____ R _____		_____
	T _____ R _____		_____
2. Property Controlling in Section	S _____ T _____ R _____		_____
	S _____ T _____ R _____		_____
3. Miscellaneous Property in Sec.	S _____ T _____ R _____		_____
	S _____ T _____ R _____		_____
4. Lot No. _____, Recorded Plat _____			
5. Private Claims _____			

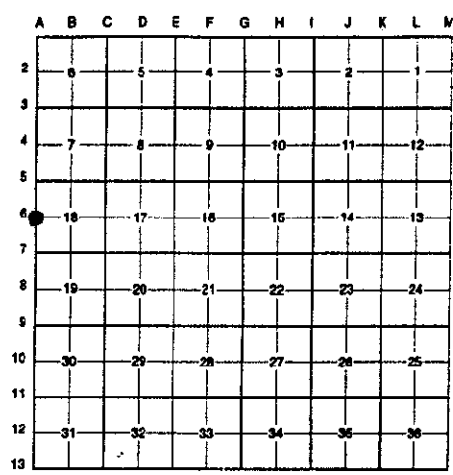

I, Randy Kolehouse, in a field survey on September 21 19 94, do hereby certify that under requirements of P.A. 74 Michigan P.A. of 1970, the corner points mentioned in lines 1 and 2 above were in conformance with regulations and rules therefore as required in the current manual of survey instructions of the United States Department of the Interior, Bureau of Land Management or by a decree of a Court of Law and/or that the corner points mentioned in lines 3, 4 and 5 above were in conformance with the rules of the Michigan Board of Land Surveyors or by a Decree of a Court of Law; established, re-established, monumented, re-monumented, recovered, found as expressed below:

NOTE: Not more than 4 corners, all in the same town and range, may be recorded on this certificate.

A. Description of original monument and accessories and/or subsequent restoration:

A-6 This corner was not originally set by G.L.O. survey.

Buckerfield Survey 1980 1/2" Iron Bar N 30° W 24.52' 12" Ash S 75° E 7.71' Twin 6" Elm N 45° E 17.8' 10" Elm S 30° W 17.9' 6" Dead Tree	L.C.R.C. L. 8132 P. 541 1982 1/2" Iron Rod N 50° W 24.49' 11" Ash N 20° E 17.17' 9" Ash S 20° E 7.68' 7" Ash S 70° W 17.78' 6" Elm	Kennedy Surveys 1983-1990 Same Witnesses as L.C.R.C. L. 8132 P. 541
--	---	--

B. Description of corner evidence found and/or method applied in restoring or reestablishing corner:

A-6 Found 1/2" iron rod in swamp 2650' ± South of the NW corner of Section 18. Checks the following witnesses.

Buckerfield Survey N 30° W 24.8' 12" Ash S 75° E 7.6' 6" Ash N 45° E 17.2' 10" Elm	L.C.R.C. L. 8132 P. 541 N 50° W 24.8' 12" Ash N 20° E 17.16' 10" Elm S 20° E 7.62' Twin 6" Ash
---	---


Kennedy Surveying = 2658.58' to A-7
 Buckerfield Eng. = 2656.65' to A-7
 Accepted 1/2" Iron Rod as Corner

C. Description of monument for corner and accessories established to perpetuate locating the position of the corner:

A-6 Set a 4" x 36" concrete monument with brass cap stamped "Oakland County Remonumentation P.S. #25854" in place of found 1/2" iron rod.

- PK Nail & Tag Stamped "Oakland Co. Remonumentation P.S. #25854" in SW Side 12" Ash N 30° W 24.86'
- PK Nail & Tag Stamped "Oakland Co. Remonumentation P.S. #25854" in N Side Twin 6" Ash S 75° E 7.62'
- PK Nail & Tag Stamped "Oakland Co. Remonumentation P.S. #25854" in NW Side 10" Elm N 45° E 17.16'
- PK Nail & Tag Stamped "Oakland Co. Remonumentation P.S. #25854" in W Side 8" Elm S 70° W 18.70'
- PK Nail & Tag Stamped "Oakland Co. Remonumentation P.S. #25854" in E Side 12" Ash S 30° W 18.87'

The selected location is accepted by the Contractor and is generally accepted by professional surveyors as the best available evidence of the position of the original corner.

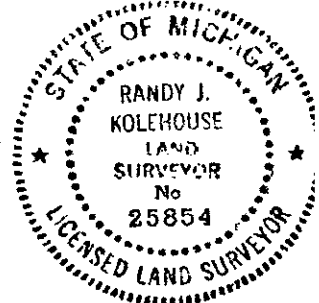

Signed by Randy J. Kolehouse Date 12/23/94
 Surveyor's Michigan License No. 25854