

COPY
JUL 27 1995 136668

LISER 15550-263

LAND CORNER RECORDATION CERTIFICATE
Filing Requirement of Act 74, Mich. P.A. 1970 \$ 7.00

MISCELLANEOUS RECORDING
\$ 2.00 REMONUMENTATION
27 JUL 95 3:33 P.M. RECEIPT# 1408
PAID RECORDED - OAKLAND COUNTY
LYNN D. ALLEN, CLERK/REGISTER OF DEEDS

For corners in
Oakland
(County)


Located in: Addison Township
Corner Code #

- 1. Public Land Survey T 5N R 11E B-1
T _____ R _____
T _____ R _____
T _____ R _____
- 2. Property Controlling in Section S _____ T _____ R _____
S _____ T _____ R _____
- 3. Miscellaneous Property in Sec. S _____ T _____ R _____
S _____ T _____ R _____

Compliance with
ACT 345, P.A. 1990

APPROVED ON: 6-19-95 Tom S
OAKLAND COUNTY REMONUMENTATION
PEER GROUP COMMITTEE
Register of Deeds Stamp & File Number

- 4. Lot No. _____, Recorded Plat _____
- 5. Private Claims _____

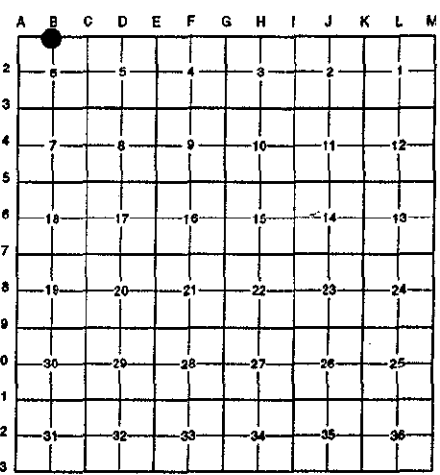

I, Randy Kolehouse, in a field survey on May 5 19 95, do hereby certify that under requirements of P.A. 74 Michigan P.A. of 1970, the corner points mentioned in lines 1 and 2 above were in conformance with regulations and rules therefore as required in the current manual of survey instructions of the United States Department of the interior, Bureau of Land Management or by a decree of a Court of Law and/or that the corner points mentioned in lines 3, 4 and 5 above were in conformance with the rules of the Michigan Board of Land Surveyors or by a Decree of a Court of Law; established, re-established, monumented, re-monumented, recovered, found as expressed below:

NOTE: Not more than 4 corners, all in the same town and range, may be recorded on this certificate.

A. Description of original monument and accessories and/or subsequent restoration:

B-1 This corner was not originally set by the G.L.O.

| | | |
|------|-----------------------|-----------------------------------|
| 1843 | County Surveyor Notes | Measured East 40.0 Chains |
| 1972 | Kieft | Cert. Survey L. 5905 P. 760 |
| 1990 | Elrich | L.C.R.C. L. 008 P. 690 |
| | | Set Iron |
| | | Found Stone at S 1/4 Cor. Sec. 31 |

B. Description of corner evidence found and/or method applied in restoring or reestablishing corner:

B-1 Found 1/2" rebar on an east/west fence and rock line. No evidence of Kieft's witnesses. Measure 334' East to a fence line that runs to the Southwest from the East/West fence line. Kieft's survey shows measurement of 332' East to fence running SW and 2639.72' West of C-1. 1843 County Surveyor's records show the N 1/4 Corner Section 6 at 40 ch. (2640') West of the NE corner of section. Checked Lapeer County records for survey information that may pertain to this corner, none on record.

Kieft = 2639.72' to C-1
Measures 2640.0 East to C1

C. Description of monument for corner and accessories established to perpetuate locating the position of the corner:

B-1 Replaced the 1/2" rebar with a 4" x 36" concrete monument with brass cap stamped "Oakland County Remonumentation P.S. #25854."


- PK Nail & Tag Stamped "Oakland Co. Remonumentation P.S. #25854" in NW Face 12" Cherry N 65° E 16.92'
- PK Nail & Tag Stamped "Oakland Co. Remonumentation P.S. #25854" in SW Face 20" Oak S 57° E 22.31'
- PK Nail & Tag Stamped "Oakland Co. Remonumentation P.S. #25854" in NW Face 20" Oak S 53° W 26.69'
- PK Nail & Tag Stamped "Oakland Co. Remonumentation P.S. #25854" in S Face 20" Oak N 51° W 21.90'

The selected location is accepted by the Contractor and is generally accepted by professional surveyors as the best available evidence of the position of the original corner.

Signed by Randy J Kolehouse
EARTH TECH

Date 7/14/95

Surveyor's Michigan License No. 25854

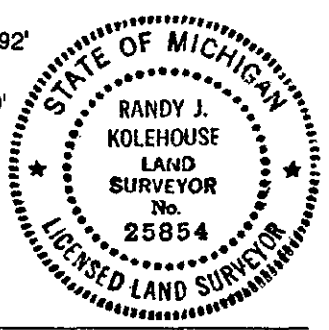

7.00
2.00 P
File