

**SURVEY &
REMONUMENTATION**

LIBER **14833 PG 152**

94 193396

MAY - 1 1995

**LAND CORNER RECORDATION CERTIFICATE
Filing Requirement of Act 74, Mich. P.A. 1970**

Compliance with
ACT 345, P.A. 1999

For corners in
Oakland

COMMISSION

APPROVED ON: 1-19-94
OAKLAND COUNTY REMONUMENTATION

PEER GROUP COMMITTEE
\$ 7.00 MISCELLANEOUS RECORDING
\$ 2.00 REMONUMENTATION
15 JUL 94 7:37 A.M. RECEIPT# 1A
PAID RECORDED - OAKLAND COUNTY
LYNN D. ALLEN, CLERK/REGISTER OF DEEDS

	Located In:		Corner Code #
	5N	11E	
1. Public Land Survey	T _____	R _____	B-3
	T _____	R _____	
	T _____	R _____	
	T _____	R _____	
2. Property Controlling in Section	S _____	T _____	
	S _____	T _____	
3. Miscellaneous Property in Sec.	S _____	T _____	
	S _____	T _____	

OK - T. SMITH

Register of Deeds Stamp & File Number

4. Lot No. _____, Recorded Plat _____
5. Private Claims _____

	A	B	C	D	E	F	G	H	I	J	K	L
2	6		5		4		3		2		1	
3		7		8		9		10		11		12
4	7		8		9		10		11		12	
5												
6	18		17		16		15		14		13	
7												
8	19		20		21		22		23		24	
9												
10	30		29		28		27		26		25	
11												
12	31		32		33		34		35		36	
13												

I, Bruce Antcliff, in a field survey on November 10, 1993, do hereby certify that under requirements of P.A. 74, Michigan P.A. of 1970, the corner points mentioned in lines 1 and 2 above were in conformance with regulations and rules therefore as required in the current manual of survey instructions of the United States Department of the Interior, Bureau of Land Management or by a decree of a Court of Law and/or that the corner points mentioned in lines 3, 4 and 5 above were in conformance with the rules of the Michigan Board of Land Surveyors or by a Decree of a Court of Law; established, re-established, monumented, re-monumented, recovered, found as expressed below:

NOTE: Not more than 4 corners, all in the same town and range, may be recorded on this certificate.

- A. Description of original monument and accessories and/or subsequent restoration:
- | | | |
|--------------|---|---|
| B-3 GLO Post | L.C.R.C. L.7524 P. 756 (1979)
Found 1/2" Iron Rod
N 10° E - 28.23' 23" Ash
N 40° W - 46.41' 21" Oak
S 35° E - 59.13' 5" Ash | L.C.R.C. L.11996 P. 027 (1991)
Found 1/2" Iron Rod
North 29.30' W Face 30" Ash
South 24.64' DNR Monument
S 45° E - 58.98' NE Face 12" Ash |
|--------------|---|---|

Survey L.6702 P. 886 (1976)
Found 1/2" Iron Rod
8" Maple SE - 58.56'
28" Maple NE - 29.23'
24" Oak NW - 46.37'

Survey L.7437 P. 890 (1979) Fnd Iron
N 10° E - 29.22' 23" Ash
N 45° W - 46.45' 21" Oak
USGS° BM South - 24.72'
S 35° E - 58.59' 5" Ash

Survey by P.E. Pangus (6/28/78)
1/2" Iron
N 40° W 46.37' 24" Oak
N 10° E 29.23' 28" Hickory
S 50° E 58.56' 8" Hickory

- B. Description of corner evidence found and/or method applied in restoring or reestablishing corner:

B-3 Found 1/2" iron bar at centerline of gravel road running E - W (Oakwood Road).
Checks the following witnesses:

Survey L.7437 P. 890 (1979)
N 10° E - 29.22' 23" Ash
USGS° BM South - 24.72'

L.C.R.C. L.11996 P. 027
North 29.30' W Face 30" Ash
South 24.64' DNR Monument
S 45° E - 58.98' NE Face 12" Ash

Survey L.6702 P. 886
8" Maple SE - 58.56'


Survey by P.E. Pangus (6/28/78)
N 10° E 29.23' 28" Hickory
S 50° E 58.56' 8" Hickory

- C. Description of monument for corner and accessories established to perpetuate locating the position of the corner:

B-3 The selected location is accepted by the Contractor and is generally accepted by professional surveyors as the best available evidence of the position of the original corner.

Set 5/8" rebar with standard Oakland County cap.

P.K. Nail and Brass Tag in W Face 12" Ash N 45° E - 36.55'
P.K. Nail and Brass Tag in W Face Twin 5" Beech S 64° W - 57.17'
P.K. Nail and Brass Tag in SW Face 12" Ash N 15° W - 37.85'
P.K. Nail and Brass Tag in SW Face 10" Ash S 45° E - 58.98'
Corner of USGS Bench Mark Monument S 00° E - 24.56'

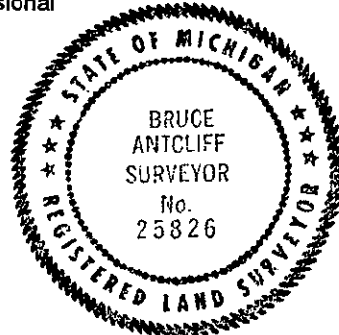

Signed by Bruce Antcliff
Surveyor's Michigan License No. 25826

Date 7-11-94