

SURVEY &
REMONUMENTATION

94 193393

LIBER 14833 PG 149

MAY - 1 1995 LAND CORNER RECORDATION CERTIFICATE
Filing Requirement of Act 74, Mich. P.A. 1970

OK - T. SMITH

For corners in
Oakland


COMMISSION

(County)	Located In:		Corner Code #
	5N	11E	
1. Public Land Survey	T _____	R _____	C-2
	T _____	R _____	
	T _____	R _____	
	T _____	R _____	
2. Property Controlling in Section	S _____	T _____	
	S _____	T _____	
3. Miscellaneous Property in Sec.	S _____	T _____	
	S _____	T _____	

\$ 7.00 MISCELLANEOUS RECORDING
\$ 2.00 REMONUMENTATION
15 JUL 94 7:37 A.M. RECEIPT# 1A
PAID RECORDED - OAKLAND COUNTY
LYNN D. ALLEN, DEPUTY REGISTER OF DEEDS
ACT 345, P.A. 1990

APPROVED ON: 1-19-94
OAKLAND COUNTY REMONUMENTATION
PEER GROUP COMMITTEE
Register of Deeds Stamp & File Number

4. Lot No. _____, Recorded Plat _____
5. Private Claims _____

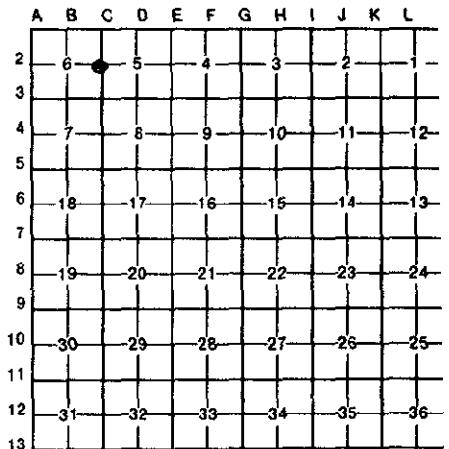

Bruce Antcliff November 10 93
I, _____, in a field survey on _____, 19 _____, do hereby certify that under requirements of P.A. 74, Michigan P.A. of 1970, the corner points mentioned in lines 1 and 2 above were in conformance with regulations and rules therefore as required in the current manual of survey instructions of the United States Department of the Interior, Bureau of Land Management or by a decree of a Court of Law and/or that the corner points mentioned in lines 3, 4 and 5 above were in conformance with the rules of the Michigan Board of Land Surveyors or by a Decree of a Court of Law, established, re-established, monumented, re-monumented, recovered, found as expressed below:

NOTE: Not more than 4 corners, all in the same town and range, may be recorded on this certificate.

A. Description of original monument and accessories and/or subsequent restoration:

C-2	GLO	L.C.R.C. L.6989 P. 251 (1977)	L.C.R.C. L.11995 P. 027 (1991)	L.C.R.C. L.7288 P. 545 (1978)
	Post	1" Iron Pipe East 26.10' 12" Oak N 30° W - 55.80' 10" Maple S 45° W - 34.12 4" Elm	3/4" Iron Pipe East 26.34 P.K. S Face 16" Oak S 70° E - 29.00' P.K. S Face 12" Oak S 15° W - 62.22' P.K. S Face 8" Oak	1" Iron Pipe N 30° W - 55.78' 12" Oak East 26.09' 12" Oak S 70° W - 34.20' 4" Elm
		Survey: L. 6989, P. 249 Same as L.C.R.C. L. 6989, P. 251	Survey: H. Kennedy (3/21/89) Same as L. 11996, P. 027	

B. Description of corner evidence found and/or method applied in restoring or reestablishing corner:

C-2 Found 1" iron pipe in centerline of gravel road running N - S (Hosner Road).
Checks the following witnesses:


L.C.R.C. L. 6989 P. 251 N 30° W - 55.80' 10" Maple East - 26.10' - 12" Oak	L.C.R.C. L. 11996 P. 027 East 26.34' P.K. S Face 16" Oak S 15° W - 62.22' 8" Oak	L.C.R.C. L.7288 P. 545 East 26.09' 12" Oak N 30° W - 55.78 12" Oak (dead)
--	--	---

C. Description of monument for corner and accessories established to perpetuate locating the position of the corner:

C-2 The selected location is accepted by the Contractor and is generally accepted by professional surveyors as the best available evidence of the position of the original corner.

Set 5/8" rebar with standard Oakland County cap.

- P.K. Nail and Brass Tag in NE Face 12" Oak S 30° E - 54.91'
- P.K. Nail and Brass Tag in SW Face Twin 12" Oak S 55° E - 29.04'
- P.K. Nail and Brass Tag in SE Face 12" Maple N 35° E - 70.89'
- P.K. Nail and Brass Tag in NW Face 14" Oak S 25° W - 62.17'

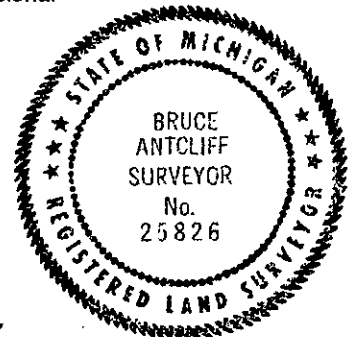

Signed by Bruce Antcliff
Surveyor's Michigan License No. 25826

Date 7-16-94