

SURVEY &  
REMONUMENTATION

LIBER 15234 PG 525

FEB 29 5 01 99 72

OK - T. SMITH

MAY - 1 1995

LAND CORNER RECORDATION CERTIFICATE

Filing Requirement of Act 74, Mich. P.A. 1970: 7.00 MISCELLANEOUS RECORDING

For corners in **COMMISSION**

Oakland (County)	Located in:	Addison Township	Corner Code #
1. Public Land Survey	T <u>5N</u>	R <u>11E</u>	<u>C-9</u>
	T _____	R _____	_____
	T _____	R _____	_____
	T _____	R _____	_____
2. Property Controlling in Section	S _____	T _____	R _____
	S _____	T _____	R _____
3. Miscellaneous Property in Sec.	S _____	T _____	R _____
	S _____	T _____	R _____

\$ 2.00 REMONUMENTATION  
2 FEB 95 7:21 A.M. RECEIPT# 2B  
PAID RECORDED - OAKLAND COUNTY  
LYNN D. ALLEN, CLERK/REGISTER OF DEEDS

Compliance with  
ACT 345, P.A. 1990

APPROVED ON: 11-30-94  
OAKLAND COUNTY REMONUMENTATION  
PEER GROUP COMMITTEE  
Register of Deeds Stamp & File Number

4. Lot No. \_\_\_\_\_, Recorded Plat \_\_\_\_\_  
5. Private Claims \_\_\_\_\_

I, Randy Kolehouse, in a field survey on June 19 94, do hereby certify that under requirements of P.A. 74 Michigan P.A. of 1970, the corner points mentioned in lines 1 and 2 above were in conformance with regulations and rules therefore as required in the current manual of survey instructions of the United States Department of the interior, Bureau of Land Management or by a decree of a Court of Law and/or that the corner points mentioned in lines 3, 4 and 5 above were in conformance with the rules of the Michigan Board of Land Surveyors or by a Decree of a Court of Law; established, re-established, monumented, re-monumented, recovered, found as expressed below:

NOTE: Not more than 4 corners, all in the same town and range, may be recorded on this certificate.

A. Description of original monument and accessories and/or subsequent restoration:

C-9 Per G.L.O. notes, J. Wampler set a post in 1817.

O.C.R.C. 1956 1/2" Iron Rod NE 49.95' W Side 18" Elm NNE 69.41' W Side 14" Elm WNW 55.78' S Side 24" Elm SW 41.39' SE Side D.E. Pole	L.C.R.C. L. 5892 P. 207 1972 1/2" Iron 12" Tree N 45° W 78.29' Tele. Pole S 42° W 44.0' Tele. Pole S 48° E 73.94'	Kennedy Survey 1985 1/2" Iron Rod N 70° E 121.02' N/W S Side 16" Ash N 70° W 79.00' N/W NE Side 12" Ash S 50° W 44.13 N/W SE Side P. Pole	Reichert Survey 1988 N 60° W 78.36' 13" Oak N 20° E 116.69 P. Pole S 50° W 44.13' P. Pole N 80° E 121.43' 18" Locust
---	---	---	--

B. Description of corner evidence found and/or method applied in restoring or reestablishing corner:

C-9 Found 1/2" iron bar at intersection Hosner Road (gravel) and Lakeville Road (asphalt) and checked the following witnesses.

L.C.R.C. L. 5892 P. 207 1972 1/2" Iron 12" Tree N 45° W 78.29' Tele. Pole S 42° W 44.0' Tele. Pole S 48° E 73.94'	Kennedy Survey 1985 N 60° W 78.97' Nail NE Side 18" Ash N 22° E 116.97' Nail W Side P. Pole N 78° E 120.69' Nail SE Side 18" Ash
---	---


Buckerfield Measures North 2734.78' to C-8  
Buckerfield Measures South 2549.99' to C-10  
Nowak Measures South 2596.51' to C-10

C. Description of monument for corner and accessories established to perpetuate locating the position of the corner:


C-9 Set a 5/8" rebar with brass cap stamped "Oakland County Remonumentation P.S. #25854" in place of found 1/2" iron rod. Also set monument box.

- PK Nail & Tag Stamped "Oakland Co. Remonumentation P.S. #25854" in SE Side P. Pole S 43° W 44.12'
- PK Nail & Tag Stamped "Oakland Co. Remonumentation P.S. #25854" in NE Side 18" Ash N 60° W 78.97'
- PK Nail & Tag Stamped "Oakland Co. Remonumentation P.S. #25854" in W Side P. Pole N 22° E 116.97'
- PK Nail & Tag Stamped "Oakland Co. Remonumentation P.S. #25854" in SE Side 18" Ash N 78° E 120.69'

The selected location is accepted by the Contractor and is generally accepted by professional surveyors as the best available evidence of the position of the original corner.

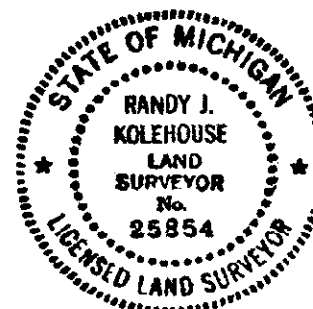

Signed by Randy J. Kolehouse Date 12/23/94  
Surveyor's Michigan License No. 25854

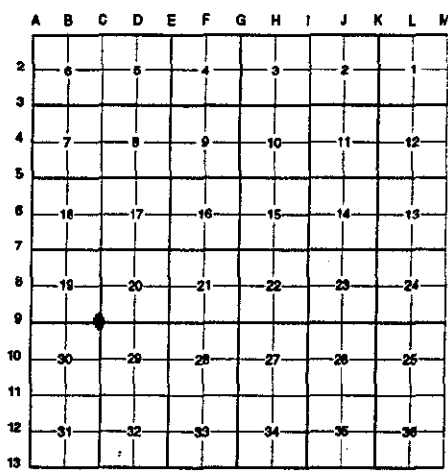

*Handwritten signature/initials*