

LAND CORNER RECORDATION CERTIFICATE
Filing Requirement of Act 74, Mich. P.A. 1970

\$ 9.00 MISCELLANEOUS RECORDING
\$ 2.00 REMONUMENTATION
27 JUL 95 3:32 P.M. RECEIPT# 1408
PAID RECORDED - OAKLAND COUNTY
LYNN D. ALLEN, CLERK/REGISTER OF DEEDS

For corners in


	Located in:	Addison Township	Corner Code #
<u>Oakland</u> (County)			
1. Public Land Survey	T <u>5N</u> R <u>11E</u>		<u>C-11</u>
	T _____ R _____		_____
	T _____ R _____		_____
	T _____ R _____		_____
2. Property Controlling in Section	S _____ T _____ R _____		_____
	S _____ T _____ R _____		_____
3. Miscellaneous Property in Sec.	S _____ T _____ R _____		_____
	S _____ T _____ R _____		_____
4. Lot No. _____, Recorded Plat _____			
5. Private Claims _____			

Compliance with
ACT 345, P.A. 1990

APPROVED ON: 6-26-95 Tom S
OAKLAND COUNTY REMONUMENTATION
PEER GROUP COMMITTEE
Register of Deeds Stamp & File Number

I, Randy Kolehouse, in a field survey on May 12 19 95, do hereby certify that under requirements of P.A. 74 Michigan P.A. of 1970, the corner points mentioned in lines 1 and 2 above were in conformance with regulations and rules therefore as required in the current manual of survey instructions of the United States Department of the Interior, Bureau of Land Management or by a decree of a Court of Law and/or that the corner points mentioned in lines 3, 4 and 5 above were in conformance with the rules of the Michigan Board of Land Surveyors or by a Decree of a Court of Law; established, re-established, monumented, re-monumented, recovered, found as expressed below:

NOTE: Not more than 4 corners, all in the same town and range, may be recorded on this certificate.

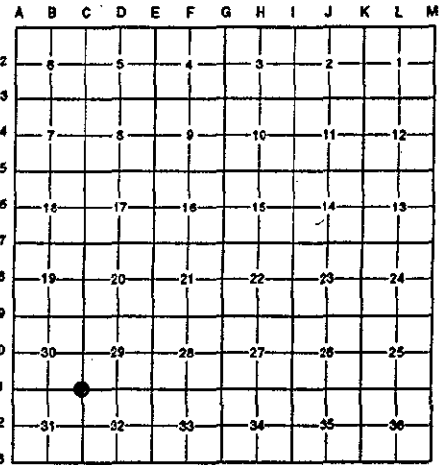

A. Description of original monument and accessories and/or subsequent restoration:

C-11	1817	Wampler	G.L.O.	Set Post
	1926	Baldwin	County Survey	
	1928	Baldwin	County Survey	I.P.
	1962	O.C.R.C.	File #134	Railroad Spike
	1975	Kennedy	Cert Survey L. 6717 P. 299	3/4" Iron
	1977	Buckerfield	L.C.R.C. L. 6877 P. 559	3/4" Iron Bar
	1978	Buckerfield	Unrecorded Survey	
	1978	Kennedy	L.C.R.C. L. 7417 P. 489	3/4" Iron

See back for continuation.

B. Description of corner evidence found and/or method applied in restoring or reestablishing corner:

C-11 Found a 5/8" rebar at the intersection of Hosner and Drahner Roads (gravel) which checks witnesses from Baldwin Survey (1928) and the witness shown in the 1962 O.C.R.C corner ties which appear to be the same as Baldwin. Also checks witnesses from above surveys and L.C.R.C.'s.

Baldwin Book 21 P. 33 1928
NE'y W Oak 40.0'
NW'y W Oak 35.2'

Ward L.C.R.C. L. 13490 P. 480 1993
N 60° W 34.95' PK & Washer S Face 29" Oak
N 60° E 38.96' PK & Washer NW Face 34" Oak
S 25° W 48.47' PK & Washer SE Face 20" Oak
N 80° W 46.71' Nail in 27" Oak

Buckerfield L.C.R.C. L. 6877 P. 559 1977
N 65° W 34.92' Spike SW Side 36" Oak
N 60° E 38.78' Spike NW Side 36" Oak
S 25° W 48.35' Spike SE Side 15" Oak


Kennedy Measured South 2616.66' to C-12
Issacs Measured West 2644.22' to B-11

C. Description of monument for corner and accessories established to perpetuate locating the position of the corner:

C-11 Replaced the 5/8" rebar with a 5/8" x 24" rebar with brass cap stamped "Oakland County Remonumentation P.S. #25854"

- PK Nail & Tag Stamped "Oakland Co. Remonumentation P.S. #25854" in SE Face 36" Oak N 60° E 39.10'
- PK Nail & Tag Stamped "Oakland Co. Remonumentation P.S. #25854" in SW Face 10" Hickory S 35° E 48.13'
- PK Nail & Tag Stamped "Oakland Co. Remonumentation P.S. #25854" in E Face 24" Oak S 20° W 48.52'
- PK Nail & Tag Stamped "Oakland Co. Remonumentation P.S. #25854" in S Face 36" Oak N 60° W 46.82'

The selected location is accepted by the Contractor and is generally accepted by professional surveyors as the best available evidence of the position of the original corner.

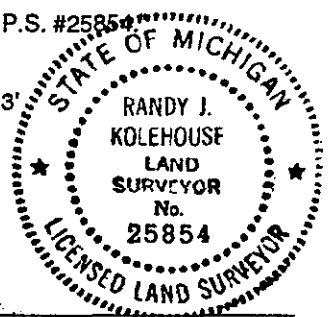

Signed by Randy J. Kolehouse Date 7/14/95
EARTH TECH
Surveyor's Michigan License No. 25854

Part "A" Continued

1989	Isaacs, Jr.	Cert. Survey L. 11006 P. 98 & 99 & L.C.R.C. L. 11006 P. 100	3/4" Pipe
1989	Scharl	Unrecorded Survey	
1989	Buckerfield	Unrecorded Survey	
1989	Buckerfield	L.C.R.C. L. 11138 P. 755	1/2" Iron
1991	Kennedy	Unrecorded Survey	5/8" Iron Rod
1991	Kennedy	L.C.R.C. L. 12730 P. 868	5/8" Iron Rod
1993	Ward	L.C.R.C. L. 13490 P. 480	5/8" Iron Rod