

JUL 27 95 1366 ZJ

LAND CORNER RECORDATION CERTIFICATE
Filing Requirement of Act 74, Mich. P.A. 1970

For corners in Oakland (County) Located in: Addison Township Corner Code #

1. Public Land Survey	T <u>5N</u>	R <u>11E</u>	<u>D-1</u>
	T _____	R _____	_____
	T _____	R _____	_____
	T _____	R _____	_____
2. Property Controlling in Section	S _____	T _____	R _____
	S _____	T _____	R _____
3. Miscellaneous Property in Sec.	S _____	T _____	R _____
	S _____	T _____	R _____

4. Lot No. _____, Recorded Plat _____

5. Private Claims _____

\$ 7.00 MISCELLANEOUS RECORDING
\$ 2.00 REMONUMENTATION
27 JUL 95 3:33 P.M. RECEIPT# 1409
PAID RECORDED - OAKLAND COUNTY
LYNN D. ALLEN, CLERK/REGISTER OF DEEDS

Compliance with ACT 345, P.A. 1990

APPROVED ON: 6-19-95 TMS
OAKLAND COUNTY REMONUMENTATION
Register of Deeds

I, Randy Kolehouse, in a field survey on May 5 19 95, do hereby certify that under requirements of P.A. 74 Michigan P.A. of 1970, the corner points mentioned in lines 1 and 2 above were in conformance with regulations and rules therefore as required in the current manual of survey instructions of the United States Department of the Interior, Bureau of Land Management or by a decree of a Court of Law and/or that the corner points mentioned in lines 3, 4 and 5 above were in conformance with the rules of the Michigan Board of Land Surveyors or by a Decree of a Court of Law; established, re-established, monumented, re-monumented, recovered, found as expressed below:

A	B	C	D	E	F	G	H	I	J	K	L
2	8	5	4	3	2	1					
3											
4	7	6	9	10	11	12					
5											
6	18	17	16	15	14	13					
7											
8	19	20	21	22	23	24					
9											
10	30	29	28	27	26	25					
11											
12	31	32	33	34	35	36					
13											

NOTE: Not more than 4 corners, all in the same town and range, may be recorded on this certificate.

A. Description of original monument and accessories and/or subsequent restoration:

D-1 This corner was not originally set by the G.L.O.

1842	County Surveyor's Notes		
1977	Pangus	Cert Survey L. 6989 P. 249	
1989	Kennedy	Unrecorded Survey	1/2" Iron Pipe

B. Description of corner evidence found and/or method applied in restoring or reestablishing corner:

D-1 Found 1/2" pipe in a swamp on line of very old fence running East & South and fence, tree and row of stones running West. Checks witnesses from Kennedy Unrecorded Survey.

Kennedy Unrecorded Survey 1989
N 15° E 33.22' PK/W W Face 10" Elm
S 10° E 7.90' PK/W E Face 13" Maple
N 40° W 28.41' PK/W SW Face 9" Elm

C. Description of monument for corner and accessories established to perpetuate locating the position of the corner:

D-1 Replaced the 1/2" iron pipe with a 4" x 36" concrete monument with brass cap stamped "Oakland County Remonumentation P.S. #25854."


PK Nail & Tag Stamped "Oakland Co. Remonumentation P.S. #25854" in W Face 10" Elm N 11° E 33.12'
PK Nail & Tag Stamped "Oakland Co. Remonumentation P.S. #25854" in N Face 18" Elm N 70° E 55.77'
PK Nail & Tag Stamped "Oakland Co. Remonumentation P.S. #25854" in E Face 12" Twin Maple S 30° E 7.97'
PK Nail & Tag Stamped "Oakland Co. Remonumentation P.S. #25854" in S Face 8" Elm N 57° W 28.36'
Found 1/2" Rebar N 13° E 15.73'

The selected location is accepted by the Contractor and is generally accepted by professional surveyors as the best available evidence of the position of the original corner.

Signed by Randy J. Kolehouse
EARTH TECH

Date 7/14/95

Surveyor's Michigan License No. 25854

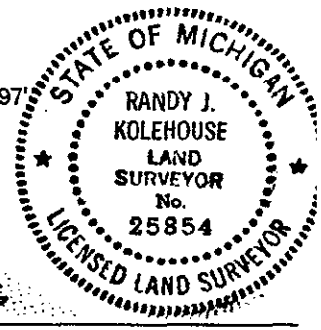

7.00
2.00
file