

MAY - 1 1995

LIBER 14833 PG 141

94 193385

COMMISSION

LAND CORNER RECORDATION CERTIFICATE  
Filing Requirement of Act 74, Mich. P.A. 1970

Compliance with ACT 345, P.A. 1990

For corners in Oakland

APPROVED ON: 7/11/94  
OAKLAND COUNTY REMONUMENTATION PEER GROUP COMMITTEE

(County)	Located In:		Corner Code #
	5N	11E	
1. Public Land Survey	T	R	E-5
	T	R	
	T	R	
	T	R	
2. Property Controlling in Section	S	T	R
	S	T	R
3. Miscellaneous Property in Sec.	S	T	R
	S	T	R

\$ 7.00 MISCELLANEOUS RECORDING  
\$ 2.00 REMONUMENTATION  
15 JUL 94 7:31 A.M. RECEIPT# 1A  
PAID RECORDED - OAKLAND COUNTY  
LYNN D. ALLEN, CLERK/REGISTER OF DEEDS

OK - T. SMITH

Register of Deeds Stamp & File Number


4. Lot No. \_\_\_\_\_, Recorded Plat \_\_\_\_\_  
5. Private Claims \_\_\_\_\_

Bruce Antcliff

November 8

93

I, \_\_\_\_\_, in a field survey on \_\_\_\_\_, 19 \_\_\_\_\_, do hereby certify that under requirements of P.A. 74, Michigan P.A. of 1970, the corner points mentioned in lines 1 and 2 above were in conformance with regulations and rules therefore as required in the current manual of survey instructions of the United States Department of the Interior, Bureau of Land Management or by a decree of a Court of Law and/or that the corner points mentioned in lines 3, 4 and 5 above were in conformance with the rules of the Michigan Board of Land Surveyors or by a Decree of a Court of Law; established, re-established, monumented, re-monumented, recovered, found as expressed below:

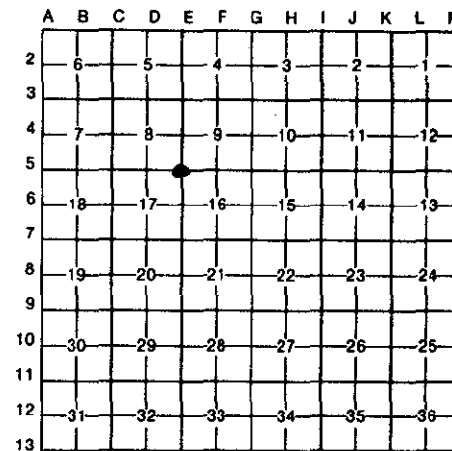

**NOTE: Not more than 4 corners, all in the same town and range, may be recorded on this certificate.**

A. Description of original monument and accessories and/or subsequent restoration:

E-5 GLO Post L.C.R.C. L.9958 P. 262 (1987)  
3/8" Iron Rod  
N 15° E - 64.28' P.K./W SE Face 25" Maple  
S 75° E - 51.47' P.K./W S Face 13" Poplar  
S 75° W - 63.65' P.K./W NW Face 31" Maple

Survey: H. Kennedy (10/11/87)  
Same as L.C.R.C. L. 9958, P. 262

B. Description of corner evidence found and/or method applied in restoring or reestablishing corner:

E-5 Found 3/8" iron rod at intersection of gravel roads (Lake George Road and Noble Road).  
Checks the following witnesses:


L.C.R.C. L. 9958, P.262  
N 15° E - 64.28' P.K. SE Face 25" Maple  
S 75° W - 63.65' P.K. NW Face 31" Maple

C. Description of monument for corner and accessories established to perpetuate locating the position of the corner:

E-5 The selected location is accepted by the Contractor and is generally accepted by professional surveyors as the best available evidence of the position of the original corner.

Set 5/8" rebar with standard Oakland County cap.

P.K. Nail and Brass Tag in SE Face 18" Oak N 20° E - 59.22'  
P.K. Nail and Brass Tag in NW Face 16" Silver Birch S 55° E - 51.61'  
P.K. Nail and Brass Tag in SE Face 38" Maple S 85° W - 63.66'  
P.K. Nail and Brass Tag in NE Face 31" Maple N 40° W - 50.44'

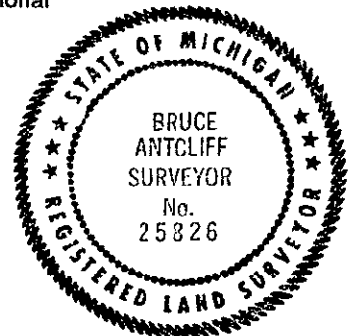

Signed by Bruce Antcliff  
25826

Date 7-11-94

Surveyor's Michigan License No. \_\_\_\_\_