

SURVEY &
REMONUMENTATION

MAY - 1 1995

LIBER 14833 PC 140

94 193384

COMMISSION LAND CORNER RECORDATION CERTIFICATE
Filing Requirement of Act 74, Mich. P.A. 1970

OK - T. SMITH

Compliance with
ACT 345, P.A. 1990

For corners in
Oakland

(County)	Located In:		Corner Code #
	5N	11E	
1. Public Land Survey	T	R	E-6
	T	R	
	T	R	
	T	R	
2. Property Controlling in Section	S	R	E-6
	S	R	
3. Miscellaneous Property in Sec.	S	R	E-6
	S	R	


APPROVED ON: 1-19-94
OAKLAND COUNTY REMONUMENTATION
PEER GROUP COMMITTEE

\$ 7.00 MISCELLANEOUS RECORDING
\$ 2.00 REMONUMENTATION
15 JUL 94 7:31 A.M. RECEIPT# 1A
PAID RECORDED - OAKLAND COUNTY
LYNN D. ALLEN, CLERK/REGISTER OF DEEDS
Register of Deeds Stamp & File Number

4. Lot No. _____, Recorded Plat _____
5. Private Claims _____

Bruce Antcliff November 9 93

I, _____, in a field survey on _____, 19 _____, do hereby certify that under requirements of P.A. 74, Michigan P.A. of 1970, the corner points mentioned in lines 1 and 2 above were in conformance with regulations and rules therefore as required in the current manual of survey instructions of the United States Department of the Interior, Bureau of Land Management or by a decree of a Court of Law and/or that the corner points mentioned in lines 3, 4 and 5 above were in conformance with the rules of the Michigan Board of Land Surveyors or by a Decree of a Court of Law; established, re-established, monumented, re-monumented, recovered, found as expressed below:

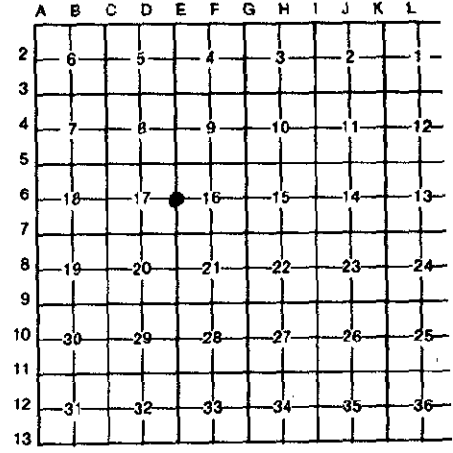

NOTE: Not more than 4 corners, all in the same town and range, may be recorded on this certificate.

A. Description of original monument and accessories and/or subsequent restoration:

E-6	GLO Post	L.C.R.C. L.7288 P. 545 (1978) Found 1/2" Iron Rod East 94.15' 15" Oak N 60° W - 54.74' 5" Ash S 70° W - 34.56' 6" Ash	L.C.R.C. L.9958 P. 262 (1987) Found 1/2" Iron Rod East 94.09' P.K./W S Face 30" Oak S 80° W - 34.54' P.K./W S Face 10" Ash N 40° W - 54.92' P.K./W S Face 31" Maple
-----	----------	---	---

B. Description of corner evidence found and/or method applied in restoring or reestablishing corner:


E-6	Found 1/2" iron bar in center line of gravel road (Lake George Road). Checks the following witnesses:	L.C.R.C. L.7288 P. 545 East 94.25' 15" Oak N 60°W - 54.74' 5" Ash	L.C.R.C. L. 9958 P. 262 East 94.09' P.K. S Face 30" Oak S 80°E - 34.54' P.K. S Side 10" Ash N 40°W - 54.92' P.K. NW Side 31" Maple
-----	--	---	---

C. Description of monument for corner and accessories established to perpetuate locating the position of the corner:

E-6 The selected location is accepted by the Contractor and is generally accepted by professional surveyors as the best available evidence of the position of the original corner.

Set 5/8" rebar with standard Oakland County cap.

- P.K. Nail and Brass Tag in S Face 30" Oak East - 94.09'
- P.K. Nail and Brass Tag in SW Face 8" Maple N 50° E - 79.45'
- P.K. Nail and Brass Tag in SW Face 10" Ash N 30° W - 54.71'
- P.K. Nail and Brass Tag in NW Face 10" Ash S 60° W - 34.41'

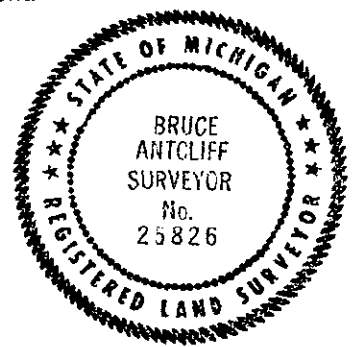

Signed by Bruce Antcliff
25826

Date 7-11-94

Surveyor's Michigan License No. _____