

SURVEY & REMONUMENTATION

MAY - 1 1995

LIBER 15234 PG 528

FEB 29 50 1997
OK - T. SMITH

LAND CORNER RECORDATION CERTIFICATE \$ 7.00 MISCELLANEOUS RECORDING
Filing Requirement of Act 74, Mich. P.A. 1970 \$ 2.00 REMONUMENTATION

For corners in

COMMISSION

2 FEB 95 7:22 A.M. RECEIPT# 2B
PAID RECORDED - OAKLAND COUNTY
LYNN D. ALLEN, CLERK/REGISTER OF DEEDS

For corners in	Located in:	Addison Township	Corner Code #
<u>Oakland</u> (County)			
1. Public Land Survey	T <u>5N</u> R <u>11E</u>		<u>E-7</u>
	T _____ R _____		_____
	T _____ R _____		_____
	T _____ R _____		_____
2. Property Controlling in Section	S _____ T _____ R _____		_____
	S _____ T _____ R _____		_____
3. Miscellaneous Property in Sec.	S _____ T _____ R _____		_____
	S _____ T _____ R _____		_____


Compliance with ACT 345, P.A. 1990

APPROVED ON: 12-12-94
OAKLAND COUNTY REMONUMENTATION PEER GROUP COMMITTEE
Register of Deeds Stamp & File Number

4. Lot No. _____, Recorded Plat _____
5. Private Claims _____

I, Randy Kolehouse, in a field survey on July 19 19 94, do hereby certify that under requirements of P.A. 74 Michigan P.A. of 1970, the corner points mentioned in lines 1 and 2 above were in conformance with regulations and rules therefore as required in the current manual of survey instructions of the United States Department of the interior, Bureau of Land Management or by a decree of a Court of Law and/or that the corner points mentioned in lines 3, 4 and 5 above were in conformance with the rules of the Michigan Board of Land Surveyors or by a Decree of a Court of Law; established, re-established, monumented, re-monumented, recovered, found as expressed below:

NOTE: Not more than 4 corners, all in the same town and range, may be recorded on this certificate.

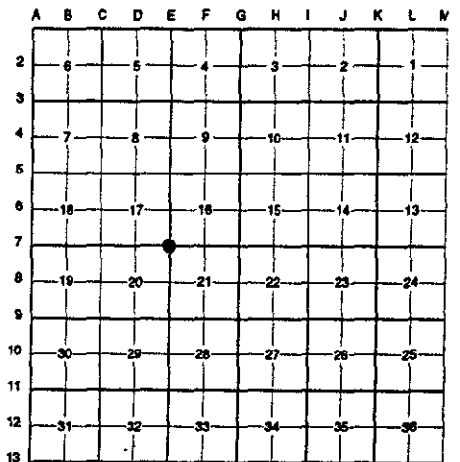

A. Description of original monument and accessories and/or subsequent restoration:

E-7 Per G.L.O. notes, J. Wampler set a post in 1817.

L.C.R.C. L 6113 P. 125 1973 Railroad Spike S 70° E 30.22' 12" Cherry S 80° W 31.28' 20" Oak N 30° W 73.28' 18" Oak	Recorded Survey L. 6717 P. 296 1976 Railroad Spike S 70° E 30.10' 15" Cherry S 85° W 30.87' 19" Oak N 20° W 73.14' 17" Oak	L.C.R.C. L. 8846 P. 262 1984 Railroad Spike S 80° W 30.35' Tw. 22" Oak N 20° W 72.81' 18" Oak N 40° W 58.00' 8" Willow S 60° W 30.08' Twin 11" Cherry	Kennedy Surveys 78, 79, 86 & 88 Railroad Spike S 80° W 30.35' Tw. 22" Oak N 20° W 72.81' 18" Oak N 40° W 58.00' 8" Willow S 60° W 30.08' Twin 11" Cherry
---	---	---	---

B. Description of corner evidence found and/or method applied in restoring or reestablishing corner:

E-7 Found 1/2" rebar C/L of Lake George Road (gravel) running N-S and checked witnesses as follows:

L.C.R.C. L. 8846 P. 262 1984 S 80° W 30.42' Tw. 20" Oak N 18° W 72.60' 24" Oak S 60° E 30.22' Twin 10" Cherry N 40° W 57.40' 10" Willow	L.C.R.C. L. 8846 P. 262 1984 S 80° W 30.42' Tw. 20" Oak N 18° W 72.60' 24" Oak S 60° E 30.22' Twin 10" Cherry N 40° W 57.40' 10" Willow
---	---


Kennedy Measures South to E-8 2496.18'

C. Description of monument for corner and accessories established to perpetuate locating the position of the corner:

E-7 Set a 5/8" rebar with brass cap stamped "Oakland County Remonumentation P.S. #25854" in place of found 1/2" rebar.

- NE Cor. Fndn. Hse. #2911 S 63° W 120.65'
- PK Nail & Tag Stamped "Oakland Co. Remonumentation P.S. #25854" in N Side Twin 20" Oak S 80° W 30.42'
- PK Nail & Tag Stamped "Oakland Co. Remonumentation P.S. #25854" in W Side 24" Oak N 18° W 72.60'
- PK Nail & Tag Stamped "Oakland Co. Remonumentation P.S. #25854" in SW Side 10" Cherry S 60° E 30.22'
- PK Nail & Tag Stamped "Oakland Co. Remonumentation P.S. #25854" in E Side 10" Willow S 40° W 57.40'

The selected location is accepted by the Contractor and is generally accepted by professional surveyors as the best available evidence of the position of the original corner.

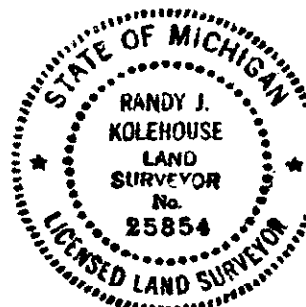

Signed by Randy J. Kolehouse Date 12/23/94
Surveyor's Michigan License No. 25854