

SURVEY & REMONUMENTATION

LIBER 15234 PG 530

FEB 29 50 1997

MAY - 1 1995

COMMISSION

LAND CORNER RECORDATION CERTIFICATE 7.00 MISCELLANEOUS RECORDING
 Filing Requirement of Act 74, Mich. P.A. 1970 2.00 REMONUMENTATION

For corners in

	Oakland (County)	Located in:	Addison Township	Corner Code #
1. Public Land Survey		T <u>5N</u>	R <u>11E</u>	<u>E-9</u>
		T _____	R _____	_____
		T _____	R _____	_____
		T _____	R _____	_____
2. Property Controlling in Section	S _____	T _____	R _____	_____
	S _____	T _____	R _____	_____
3. Miscellaneous Property in Sec.	S _____	T _____	R _____	_____
	S _____	T _____	R _____	_____

2 FEB 95 7:22 A.M. RECEIPT# 2B
 PAID RECORDED - OAKLAND COUNTY
 LYNN D. ALLEN, CLERK/REGISTER OF DEEDS

OK - T. SMITH

Compliance with
 ACT 345, P.A. 1990

APPROVED ON: 11-30-94
 OAKLAND COUNTY REMONUMENTATION
 PRR GROUP COMMITTEE
 Register of Deeds Stamp & File Number

4. Lot No. _____, Recorded Plat _____
 5. Private Claims _____

I, Randy Kolehouse in a field survey on July 27 19 94, do hereby certify that under requirements of P.A. 74 Michigan P.A. of 1970, the corner points mentioned in lines 1 and 2 above were in conformance with regulations and rules therefore as required in the current manual of survey instructions of the United States Department of the interior, Bureau of Land Management or by a decree of a Court of Law and/or that the corner points mentioned in lines 3, 4 and 5 above were in conformance with the rules of the Michigan Board of Land Surveyors or by a Decree of a Court of Law; established, re-established, monumented, re-monumented, recovered, found as expressed below:

NOTE: Not more than 4 corners, all in the same town and range, may be recorded on this certificate.

A. Description of original monument and accessories and/or subsequent restoration:

E-9 Per G.L.O. notes, J. Wampler set a post in 1817.

O.C.R.C. 1940 NW 55.08' Spike in 28° Elm NE Conc. Retaining Wall 67.90' ENE Conc. Retaining Wall 52.95' SE 49.00' Spike in 48° Elm	L.C.R.C. L. 6113 P. 125 1973 P.K. Nail N 45° W 60.45' P. Pole N 45° E 41.31' Street Sign S 70° E 70.67' P. Pole	Kobs Survey 1978 P.K. & Brass Washer NW 60.45' Nail & Cap in P. Pole NE 41.31' Street Sign 78.60' Power Pole	Recorded Survey L. 8689 P. 719 1984 P.K. Nail S 70° W 96.60' NW N Side P. Pole N 70° W 73.35' NW S Side P. Pole S 15° E 79.65' NW W Side P. Pole S 70° E 78.73' NW W Side P. Pole
--	---	--	--

B. Description of corner evidence found and/or method applied in restoring or reestablishing corner:

E-9 Found 1/2" iron bar 4' North of the C/L of Lakeville Road (gravel) running E-W and 4' East of C/L of Lake George Road (gravel) running North and 4' West of C/L of Lake George Road running South.

O.C.R.C. NNE End Retaining Wall 67.6' ENE End Retaining Wall 53.6'	L.C.R.C. L. 6113 P. 125 N 53° E 41.22' C/L Sign Post	Kobs Survey 1978 NE 41.31' Street Sign	Recorded Survey L. 8689 P. 719 1984 N 65° W 73.04' NW S Side P. Pole S 75° W 96.42' NW N Side P. Pole S 60° E 77.42' NW NE Side P. Pole
--	---	---	--


Baldwin Measures North 2842.63' to E-8
 Baldwin Measures West 2645.06' to D-9
 Baldwin Measures South 5266.45' to E-11
 Kobs Measures East 2996.47' to F-9

C. Description of monument for corner and accessories established to perpetuate locating the position of the corner:

E-9 Set a 5/8" rebar with brass cap stamped "Oakland County Remonumentation P.S. #25854" in place of found 1/2" iron rod. Also set monument box.

PK Nail & Tag Stamped "Oakland Co. Remonumentation P.S. #25854" in S Side P. Pole S 65° W 73.04'
 PK Nail & Tag Stamped "Oakland Co. Remonumentation P.S. #25854" in N Side P. Pole S 75° W 96.42'
 PK Nail & Tag Stamped "Oakland Co. Remonumentation P.S. #25854" in NE Side P. Pole S 60° E 77.42'
 C/L Sign Post N 53° E 41.22'
 PK Nail & Tag Stamped "Oakland Co. Remonumentation P.S. #25854" in W Side (Cut) D.E. Pole S 15° E 79.65'

The selected location is accepted by the Contractor and is generally accepted by professional surveyors as the best available evidence of the position of the original corner.

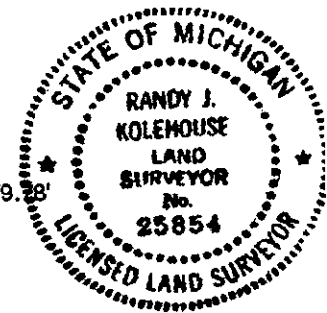

Signed by Randy Kolehouse Date 12/23/94
 Surveyor's Michigan License No. 25854