

LAND CORNER RECORDATION CERTIFICATE Filing Requirement of Act 74, Mich. P.A. 1970

For corners in

Form with fields for Location (Oakland County), Addison Township, Corner Code # (E-10), and numbered sections 1-5 for survey details.

MISCELLANEOUS RECORDING \$ 7.00 REMONUMENTATION \$ 2.00 27 JUL 95 3:34 P.M. RECEIPT# 140B PAID RECORDED - OAKLAND COUNTY LYNN D. ALLEN, CLERK/REGISTER OF DEEDS

Compliance with ACT 345, P.A. 1990 APPROVED ON: 6-19-95 Toms OAKLAND COUNTY REMONUMENTATION PEER GROUP COMMITTEE

Register of Deeds Stamp & File Number

I, Randy Kolehouse, in a field survey on May 12 19 95, do hereby certify that under requirements of P.A. 74 Michigan P.A. of 1970, the corner points mentioned in lines 1 and 2 above were in conformance with regulations and rules therefore as required in the current manual of survey instructions of the United States Department of the Interior, Bureau of Land Management or by a decree of a Court of Law and/or that the corner points mentioned in lines 3, 4 and 5 above were in conformance with the rules of the Michigan Board of Land Surveyors or by a Decree of a Court of Law; established, re-established, monumented, re-monumented, recovered, found as expressed below:

NOTE: Not more than 4 corners, all in the same town and range, may be recorded on this certificate.

A. Description of original monument and accessories and/or subsequent restoration:

Table with 4 columns: Survey No. (E-10 1817, 1927, 1978), Name (Wampler, Baldwin, Buckerfield, Kennedy), Status (G.L.O., Unrecorded Survey, Field File), and Description (Point Inaccessible - Corner Not Set, Found Original Stone/Set Iron Post over Stone, Found 3/4" Iron Bar, 1/2" Iron Rod).

B. Description of corner evidence found and/or method applied in restoring or reestablishing corner:

E-10 Found a 3/4" iron bar at C/L of Lake George Road on an old fence line East and an old fence rock line West. Also found capped iron #22445 13.64' North of this iron. The 3/4" iron bar agrees with Buckerfield and Baldwin's Surveys.

Baldwin Unrecorded Survey 1927 East 82.03' 14" Oak Found 48" Stump Buckerfield Unrecorded Survey 1978 N 75° E 28.68' 5" Tree (Found 10" Ash) S 30° E 46.68' 30" Tree (Found 36" Stump)

Measured North to Northwest Corner 2634.91' (Buckerfield 2634.21') Measured South to Southwest Corner 2627.27' Total Miles Measured 5262.17' (Baldwin 5266.45') (G.L.O. 5280')


C. Description of monument for corner and accessories established to perpetuate locating the position of the corner:

E-10 Replaced the 3/4" iron bar with a 5/8" x 24" rebar with brass cap stamped "Oakland County Remonumentation P.S. #25854."

- PK Nail & Tag Stamped "Oakland Co. Remonumentation P.S. #25854" in SE Face 12" Willow N 39° E 63.21'
- PK Nail & Tag Stamped "Oakland Co. Remonumentation P.S. #25854" in S Face 12" Ash N 82° E 23.03'
- PK Nail & Tag Stamped "Oakland Co. Remonumentation P.S. #25854" in W Face 8" Oak S 20° E 50.63'
- PK Nail & Tag Stamped "Oakland Co. Remonumentation P.S. #25854" in N Face 6" Maple S 75° W 39.88'

The selected location is accepted by the Contractor and is generally accepted by professional surveyors as the best available evidence of the position of the original corner.

Signed by Randy J Kolehouse Date 7/14/95 Surveyor's Michigan License No. 25854

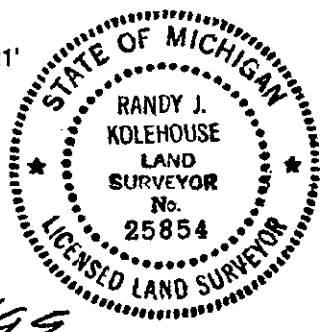

Handwritten note: 7.00 2.00 file