

**SURVEY & REMONUMENTATION**

MAY 16 1996

LIBER 15913 PG 757

**LAND CORNER RECORDATION CERTIFICATE**  
Filing Requirement of Act 74, Mich. P.A. 1970

Compliance with ACT 345, P.A. 1990

**COMMISSION**

APPROVED ON: 6-20-95 T.S.  
OAKLAND COUNTY REMONUMENTATION PEER GROUP COMMITTEE

For corners in

Oakland (County)	Located in:	Addison Township	Corner Code #
1. Public Land Survey	T 5N R 11E	E-13	
	T R		
	T R		
	T R		
2. Property Controlling in Section	S T R		
	S T R		
3. Miscellaneous Property in Sec.	S T R		
	S T R		

\$ 7.00 MISCELLANEOUS RECORDING  
\$ 2.00 REMONUMENTATION  
29 DEC 95 9:02 A.M. RECEIPT# 44A  
PAID RECORDED - OAKLAND COUNTY  
LYNN D. ALLEN, CLERK/REGISTER OF DEEDS

Register of Deeds Stamp & File Number

- 4. Lot No. \_\_\_\_\_, Recorded Plat \_\_\_\_\_
- 5. Private Claims \_\_\_\_\_

I, Randy Kolehouse, in a field survey on May 4 19 95, do hereby certify that under requirements of P.A. 74 Michigan P.A. of 1970, the corner points mentioned in lines 1 and 2 above were in conformance with regulations and rules therefore as required in the current manual of survey instructions of the United States Department of the interior, Bureau of Land Management or by a decree of a Court of Law and/or that the corner points mentioned in lines 3, 4 and 5 above were in conformance with the rules of the Michigan Board of Land Surveyors or by a Decree of a Court of Law; established, re-established, monumented, re-monumented, recovered, found as expressed below:

**NOTE: Not more than 4 corners, all in the same town and range, may be recorded on this certificate.**

A. Description of original monument and accessories and/or subsequent restoration:

E-13	1817	Wampler	G.L.O.	Set Post
	1926	Baldwin	Unrecorded	
	1962	O.C.R.C.	File #162	
	1980	Walker		Found Iron
	1993	Ward	L.C.R.C. L. 15213 P. 037	Set 2" Brass Remon. Cap

B. Description of corner evidence found and/or method applied in restoring or reestablishing corner:

E-13 Found Oakland County monument with a 2" brass cap "Oakland County Remonumentation #22445" at the C/L of Lake George Road with a fence line to the East and a two track to the West which checks on witnesses from 1962 O.C.R.C. Section Corner file and witnesses from 1980 Walker Survey and 1993 L.C.R.C. L. 15213 P. 307 as filed by G. Ward for E-1 T4N R11E Oakland Township. Baldwin Survey 1926 shows measurement of 5259.5' to SW corner Section 33. Walker Survey shows measurement of 5256.9' to SW corner Section 33 (-26'). G.L.O. Notes show corner common with Oakland Township and is being held common with Oakland Township.

Walker Unrecorded Survey 1980  
N 75° W 49.0' Nail in 14" Oak  
S 45° W 45.39' Nail in 24" Walnut  
S 85° E 37.35' Nail in 12" Walnut

Ward L.C.R.C. L. 15213 P. 037  
S 52° W 45.72 PK Nail & B.D. #22445 NW side 24" Hickory  
N 78° E 49.73' PK Nail & B.D. #22445 S side 14" Oak  
N 36° W 55.56' PK Nail & B.D. #22445 NE side 8" Ash  
S 58° E 40.06' PK Nail & B.D. #22445 N side 6" Ash

C. Description of monument for corner and accessories established to perpetuate locating the position of the corner:

E-13 4" concrete monument with brass cap stamped "Oakland County Remonumentation P.S. #22445."

PK Nail & Tag Stamped "Oakland Co. Remonumentation P.S. #22445" in N Side 12" Twin Elm S 56° E 40.06'  
PK Nail & Tag Stamped "Oakland Co. Remonumentation P.S. #22445" in NW Side 24" Oak S 50° W 45.68'  
PK Nail & Tag Stamped "Oakland Co. Remonumentation P.S. #22445" in S Side 12" Oak N 78° W 79.74'  
PK Nail & Tag Stamped "Oakland Co. Remonumentation P.S. #22445" in E Side 10" Poplar N 36° W 55.53'  
USGS Survey Monument #I123C N28° E 66.45'


The selected location is accepted by the Contractor and is generally accepted by professional surveyors as the best available evidence of the position of the original corner.

Signed by Randy J. Kolehouse  
EARTH TECH

Date 12/22/95

Surveyor's Michigan License No. 25854

	A	B	C	D	E	F	G	H	I	J	K	L	M
2	6	5	4	3	2	1							
3													
4	7	8	9	10	11	12							
5													
6	18	17	16	15	14	13							
7													
8	19	20	21	22	23	24							
9													
10	30	29	28	27	26	25							
11													
12	31	32	33	34	35	36							
13													

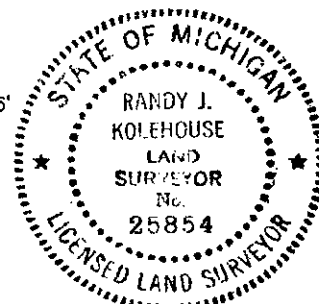

7.00  
2.00  
File