

**SURVEY &  
REMONUMENTATION**

LIBER **14833** PG **139**

**94 193383**

Compliance with  
ACT 345, P.A. 1990

MAY - 1 1995

**LAND CORNER RECORDATION CERTIFICATE**

Filing Requirement of Act 74, Mich. P.A. 1970

For corners in  
Oakland

**COMMISSION**

APPROVED ON: 12-22-93  
OAKLAND COUNTY REMONUMENTATION  
PEER GROUP COMMITTEE

(County)	Located In:		Corner Code #
	5N	11E	F-3
1. Public Land Survey	T _____	R _____	_____
	T _____	R _____	_____
	T _____	R _____	_____
	T _____	R _____	_____
2. Property Controlling in Section	S _____	T _____	R _____
	S _____	T _____	R _____
3. Miscellaneous Property in Sec.	S _____	T _____	R _____
	S _____	T _____	R _____

\$ 7.00 MISCELLANEOUS RECORDING  
\$ 2.00 REMONUMENTATION  
15 JUL 94 7:31 A.M. RECEIPT 1A  
PAID RECORDED - OAKLAND COUNTY  
LYNN D. ALLEN, CLERK/REGISTER OF DEEDS

**OK - T. SMITH**

Register of Deeds Stamp & File Number

4. Lot No. \_\_\_\_\_, Recorded Plat \_\_\_\_\_  
5. Private Claims \_\_\_\_\_

	A	B	C	D	E	F	G	H	I	J	K	L
2	6	5	4	3	2	1						
3												
4	7	8	9	10	11	12						
5												
6	18	17	16	15	14	13						
7												
8	19	20	21	22	23	24						
9												
10	30	29	28	27	26	25						
11												
12	31	32	33	34	35	36						
13												

I, Bruce Antcliff, in a field survey on November 9, 1993, do hereby certify that under requirements of P.A. 74, Michigan P.A. of 1970, the corner points mentioned in lines 1 and 2 above were in conformance with regulations and rules therefore as required in the current manual of survey instructions of the United States Department of the Interior, Bureau of Land Management or by a decree of a Court of Law and/or that the corner points mentioned in lines 3, 4 and 5 above were in conformance with the rules of the Michigan Board of Land Surveyors or by a Decree of a Court of Law; established, re-established, monumented, re-monumented, recovered, found as expressed below:

**NOTE: Not more than 4 corners, all in the same town and range, may be recorded on this certificate.**

A. Description of original monument and accessories and/or subsequent restoration:

F-3	GLO Post	L.C.R.C. L. 6575, P. 114 (1975) 1/2" Iron Pin in Fence Cor. S 50° W 10.0 13" Oak East 18.43 7" Oak S 70° E 20.88 8" Maple	Survey L. 6423, P. 771 (1975) Same Witness as L.C.R.C. L. 6575, P. 114	Survey L. 8335, P. 347 (1981) 1/2" Rerod S 80° E 18.67 8" Oak S 45° E 20.97 8" Maple S ?? W 10.05 15" Oak
-----	----------	---	---	---

B. Description of corner evidence found and/or method applied in restoring or reestablishing corner:

F-3 Reset capped 1/2" iron using Survey L. 8335, P. 349, and survey L. 6423, P. 771. This location is 0.5' South and 0.5' East of old corner fence post.  
Checks the following witnesses:

L.C.R.C. L. 6575, P. 114  
7" Oak E 18.43  
8" Maple S 70° E 20.88


Survey L. 8335, P. 347  
S 45° E 20.97 8" Maple  
S 80° E 18.67 8" Oak (Sassafrass)

C. Description of monument for corner and accessories established to perpetuate locating the position of the corner:

F-3 The selected location is accepted by the Contractor and is generally accepted by professional surveyors as the best available evidence of the position of the original corner.

Set concrete monument with standard Oakland County cap.

- P.K. Nail and Brass Tag in S Side 10" Sassafrass - East - 18.46
- P.K. Nail and Brass Tag in SW Side 12" Maple - S 45° E - 20.78
- P.K. Nail and Brass Tag in E Side 12" Oak - South - 32.07
- P.K. Nail and Brass Tag in N Side 14" Oak - S 70° W - 24.34
- Iron - West - 68.03

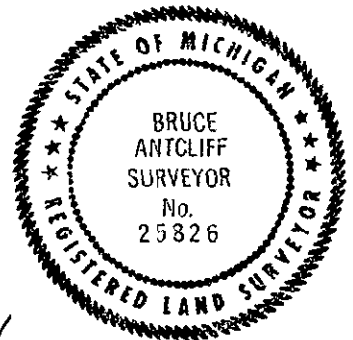

Signed by Bruce Antcliff  
725826

Date 7-11-94

Surveyor's Michigan License No. \_\_\_\_\_