

**SURVEY & REMONUMENTATION**

LIBER 14833 PG 138

OK - T. SMITH  
94 193382

MAY - 1 1995

**LAND CORNER RECORDATION CERTIFICATE**  
Filing Requirement of Act 74, Mich. P.A. 1970

Compliance with  
ACT 345, P.A. 1990

For corners in  
Oakland

**COMMISSION**

APPROVED ON: 1-19-94  
OAKLAND COUNTY REMONUMENTATION  
PEER GROUP COMMITTEE

|                                    | Located In: |         | Corner Code # |
|------------------------------------|-------------|---------|---------------|
|                                    | 5N          | 11E     |               |
| 1. Public Land Survey              | T _____     | R _____ | F-5           |
|                                    | T _____     | R _____ |               |
|                                    | T _____     | R _____ |               |
|                                    | T _____     | R _____ |               |
| 2. Property Controlling in Section | S _____     | T _____ |               |
|                                    | S _____     | T _____ |               |
| 3. Miscellaneous Property in Sec.  | S _____     | T _____ |               |
|                                    | S _____     | T _____ |               |

\$ 7.00 MISCELLANEOUS RECORDING  
\$ 2.00 REMONUMENTATION  
15 JUL 94 7:31 A.M. RECEIPT# 1A  
PAID RECORDED - OAKLAND COUNTY  
LYNN D. ALLEN, CLERK/REGISTER OF DEEDS

Register of Deeds Stamp & File Number

4. Lot No. \_\_\_\_\_, Recorded Plat \_\_\_\_\_  
5. Private Claims \_\_\_\_\_

|    | A  | B  | C  | D  | E  | F  | G | H | I | J | K | L |
|----|----|----|----|----|----|----|---|---|---|---|---|---|
| 2  | 6  | 5  | 4  | 3  | 2  | 1  |   |   |   |   |   |   |
| 3  |    |    |    |    |    |    |   |   |   |   |   |   |
| 4  | 7  | 8  | 9  | 10 | 11 | 12 |   |   |   |   |   |   |
| 5  |    |    |    |    |    |    |   |   |   |   |   |   |
| 6  | 18 | 17 | 16 | 15 | 14 | 13 |   |   |   |   |   |   |
| 7  |    |    |    |    |    |    |   |   |   |   |   |   |
| 8  | 19 | 20 | 21 | 22 | 23 | 24 |   |   |   |   |   |   |
| 9  |    |    |    |    |    |    |   |   |   |   |   |   |
| 10 | 30 | 29 | 28 | 27 | 26 | 25 |   |   |   |   |   |   |
| 11 |    |    |    |    |    |    |   |   |   |   |   |   |
| 12 | 31 | 32 | 33 | 34 | 35 | 36 |   |   |   |   |   |   |
| 13 |    |    |    |    |    |    |   |   |   |   |   |   |

Bruce Antcliff

November 9

93

I, \_\_\_\_\_, in a field survey on \_\_\_\_\_, 19 \_\_\_\_\_, do hereby certify that under requirements of P.A. 74, Michigan P.A. of 1970, the corner points mentioned in lines 1 and 2 above were in conformance with regulations and rules therefore as required in the current manual of survey instructions of the United States Department of the Interior, Bureau of Land Management or by a decree of a Court of Law and/or that the corner points mentioned in lines 3, 4 and 5 above were in conformance with the rules of the Michigan Board of Land Surveyors or by a Decree of a Court of Law, established, re-established, monumented, re-monumented, recovered, found as expressed below:

**NOTE: Not more than 4 corners, all in the same town and range, may be recorded on this certificate.**

- A. Description of original monument and accessories and/or subsequent restoration:  
F-5 GLO L.C.R.C. L. 6309, P. 787 (1974) L.C.R.C. L. 7417, P. 489 (1979)  
Post 1/2" Iron Bar CL Curtis Rd & Noble Rd S 70° E 47.87' to 38" Oak  
N 42° W 43.43' 6" Ash S 20° W 59.72' to 34" Oak  
S 80° E 47.74' 41" Oak N 20° W 53.93' to 24" Ash  
S 38° W 60.06' 30" Oak

Kennedy Survey #88-2319 & 91-3043 (1988 & 1991)  
1/2 Iron Rod  
S 70° E 47.87' 42" Oak  
S 30° W 59.75' 38" Oak  
N 30° W 54.00' 27" Ash

L.C.R.C. L. 10999, P. 837 (1987)  
S 70° E 47.87' to PK/W S Face 42" Oak  
S 30° W 59.75' to PI/W E Side 38" Oak  
N 30° W 54.00' to PK/W SW Face 27" Ash

- B. Description of corner evidence found and/or method applied in restoring or reestablishing corner:

F-5 Found 1/2" rebar at intersection of Curtis Road and Noble Road.  
Checks the following witnesses:

L.C.R.C. L. 6309, P. 787 (1974)  
N 42° W 43.43' 6" Ash  
S 80° E 47.74' 41" Oak  
S 38° W 60.06' 30" Oak

L.C.R.C. L. 7417, P. 489  
S 20° W 59.72' 34" Oak  
S 70° E 47.87' 38" Oak


L.C.R.C. L. 10999, P. 837  
S 30° W 59.75' PK E Side 38" Oak  
N 30° W 54.0 27" Ash

Kennedy Survey #88-2319 & 91-3043 (1988 & 1991)  
S 70° E 47.87' 42" Oak  
N 30° W 54.00' 27" Ash

- C. Description of monument for corner and accessories established to perpetuate locating the position of the corner:  
F-5 The selected location is accepted by the Contractor and is generally accepted by professional surveyors as the best available evidence of the position of the original corner.

Set 5/8" rebar with standard Oakland County cap.

P.K. Nail and Brass Tag in E Face 36" Oak - S 30° W - 59.04'  
P.K. Nail and Brass Tag in N. Face 38" Oak - S 70° E - 47.32'  
P.K. Nail and Brass Tag in SW Face 12" Ash - N 40° W - 43.11'  
P.K. Nail and Brass Tag in E Face 26" Ash - N 15° W - 53.88'

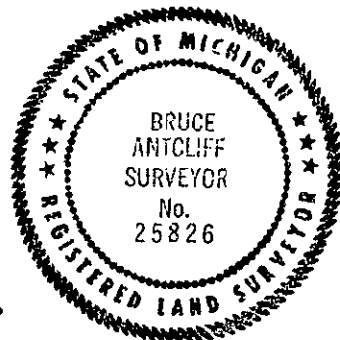

Signed by Bruce Antcliff  
Surveyor's Michigan License No. 25826

Date 7-11-94