

**SURVEY &
REMONUMENTATION**

LIBER 14833 PG 137

94 193381

MAY - 1 1995

LAND CORNER RECORDATION CERTIFICATE

COMMISSION Filing Requirement of Act 74, Mich. P.A. 1970


For corners in
Oakland

(County)	Located In:	Corner Code #
	5N 11E	F-7
1. Public Land Survey	T ___ R ___ T ___ R ___ T ___ R ___ T ___ R ___	_____ _____ _____ _____
2. Property Controlling in Section	S ___ T ___ R ___ S ___ T ___ R ___	_____ _____
3. Miscellaneous Property in Sec.	S ___ T ___ R ___ S ___ T ___ R ___	_____ _____

OK - T. SMITH

\$ 7.00 MISCELLANEOUS RECORDING
\$ 2.00 REMONUMENTATION
15 JUL 94 7:31 A.M. RECEIPT# 1A
PAID Compliance with ACT 302 OF 1990 OAKLAND COUNTY
LYNN D. ALLEN, CLERK/REGISTER OF DEEDS
APPROVED ON: 7-11-94
OAKLAND COUNTY REMONUMENTATION
PEER GROUP COMMITTEE
Register of Deeds Stamp & File Number

4. Lot No. _____, Recorded Plat _____
5. Private Claims _____

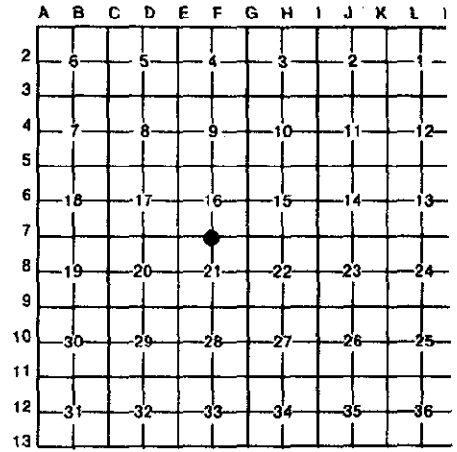

I, Bruce Antcliff in a field survey on November 11, 1993
do hereby certify that under requirements of P.A. 74, Michigan P.A. of 1970, the corner points mentioned in lines 1 and 2 above were in conformance with regulations and rules therefore as required in the current manual of survey instructions of the United States Department of the Interior, Bureau of Land Management or by a decree of a Court of Law and/or that the corner points mentioned in lines 3, 4 and 5 above were in conformance with the rules of the Michigan Board of Land Surveyors or by a Decree of a Court of Law; established, re-established, monumented, re-monumented, recovered, found as expressed below:

NOTE: Not more than 4 corners, all in the same town and range, may be recorded on this certificate.

A. Description of original monument and accessories and/or subsequent restoration:

F-7	GLO Post	County Witness North - 38.0' Nail 24" Oak NE - 49.8' Nail 12" Oak SSW - 84.25' Nail 30" Oak	L.C.R.C. L. 6034, P. 630 (1972) 3/4" Pipe NW - 27.68' to NW 12" Twin Oak NE - 43.82' to NW 24" Oak SE - 47.97' to NW Power Pole	L.C.R.C. L. 10341, P. 880 (1988) 1" Pipe N 20° E - 44.08' NW, E Face 25" Oak S 70° E - 48.77' NW, N Face Power Pole N 15° W - 27.66' NW, W Face 13" Cherry
-----	----------	--	---	--

B. Description of corner evidence found and/or method applied in restoring or reestablishing corner:

F-7 Found 1/2" rebar ± 15' West of gravel road (Curtis Road) on line of Army Road East. Measure East 1,425' to fence line running North and 2,849' to SE corner section.
Checks the following witnesses:


L.C.R.C. L. 6034, P. 630 Nail and Tag in 24" Oak NE - 43.82'	L.C.R.C. L. 10341, P. 880 N 20° E - 44.08' Nail East Side 25" Oak S 70° E - 48.77' Nail North Side Power Pole
---	---

C. Description of monument for corner and accessories established to perpetuate locating the position of the corner:

F-7 The selected location is accepted by the Contractor and is generally accepted by professional surveyors as the best available evidence of the position of the original corner.

Set concrete monument with standard Oakland County cap.

- P.K. Nail and Brass Tag in SW Face Power Pole - S 50° E - 48.63'
- P.K. Nail and Brass Tag in SW Face 22" Elm - S 18° E - 90.60'
- P.K. Nail and Brass Tag in N Face 6" Elm - S 67° W - 7.28'
- P.K. Nail and Brass Tag in E Face Twin 14" Oak - N 31° E - 43.61'

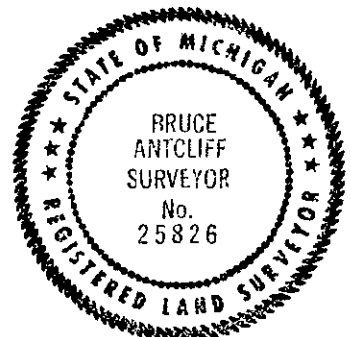

Signed by Bruce Antcliff
Surveyor's Michigan License No. 25826

Date 7-11-94