

NUMBER 15550-273

JUL 27 95 136678

LAND CORNER RECORDATION CERTIFICATE  
Filing Requirement of Act 74, Mich. P.A. 1970

\$ 7.00 MISCELLANEOUS RECORDING  
\$ 2.00 REMONUMENTATION  
27 JUL 95 3:34 P.M. RECEIPT# 1408  
PAID RECORDED - OAKLAND COUNTY  
LYNN D. ALLEN, CLERK/REGISTER OF DEEDS

For corners in

Oakland  
(County)

Located in: Addison Township Corner Code #


- 1. Public Land Survey T 5N R 11E F-13  
T \_\_\_\_\_ R \_\_\_\_\_  
T \_\_\_\_\_ R \_\_\_\_\_  
T \_\_\_\_\_ R \_\_\_\_\_
- 2. Property Controlling in Section S \_\_\_\_\_ T \_\_\_\_\_ R \_\_\_\_\_  
S \_\_\_\_\_ T \_\_\_\_\_ R \_\_\_\_\_
- 3. Miscellaneous Property in Sec. S \_\_\_\_\_ T \_\_\_\_\_ R \_\_\_\_\_  
S \_\_\_\_\_ T \_\_\_\_\_ R \_\_\_\_\_

Compliance with ACT 345, P.A. 1990  
APPROVED ON: 6-26-95  
OAKLAND COUNTY REMONUMENTATION PEER GROUP COMMITTEE  
Register of Deeds Stamp & File Number

- 4. Lot No. \_\_\_\_\_, Recorded Plat \_\_\_\_\_
- 5. Private Claims \_\_\_\_\_

I, Randy Kolehouse, in a field survey on May 23 19 95, do hereby certify that under requirements of P.A. 74 Michigan P.A. of 1970, the corner points mentioned in lines 1 and 2 above were in conformance with regulations and rules therefore as required in the current manual of survey instructions of the United States Department of the interior, Bureau of Land Management or by a decree of a Court of Law and/or that the corner points mentioned in lines 3, 4 and 5 above were in conformance with the rules of the Michigan Board of Land Surveyors or by a Decree of a Court of Law; established, re-established, monumented, re-monumented, recovered, found as expressed below:

NOTE: Not more than 4 corners, all in the same town and range, may be recorded on this certificate.

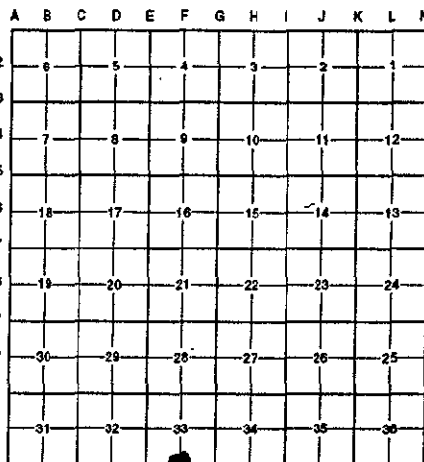

A. Description of original monument and accessories and/or subsequent restoration:

F-13	1817	Wampler	G.L.O.	Set Post
	1926	Baldwin	Survey	N/A
	1980	Walker	Unrecorded Survey	N/A
	1993	Ward	L.C.R.C. L. 15095 P. 019	O.C. Monument
F1 T4N R11E				


B. Description of corner evidence found and/or method applied in restoring or reestablishing corner:

F-13 Found a standard Oakland County Monument as set by G. Ward for F-13, T4N R11E.  
G.L.O. measurements set corner at midpoint 40 ch. West to E-13, 40 ch. East to G-13.  
Baldwin (1926) measured West 2829.6' to E-13 and East 2829.8' to G-13 which places corner at approximate midpoint.  
Walker (1980) measured West 2888.94' West to E-13 and 2769.82 East to G-13 making the S 1/4 shown in Walker Survey 59.6' East of midpoint.  
Measured West from monument at G-1, T4N R11E 64.2'. Found an old iron in C/L of two tracks running East.  
Measured East from F-1 2770.0' M/L to G-13 or approximately 60.0' short of midpoint.

7.00  
2.00  
file

C. Description of monument for corner and accessories established to perpetuate locating the position of the corner:

F-13 Replaced the 5/8" rebar with a 4" x 36" concrete monument with brass cap stamped "Oakland County Remonumentation P.S. #25854."  
Conc. Mon. with 2" Brass O.C. Remon. Cap #22445 S 82° E 64.19'  
PK Nail & Tag Stamped "Oakland Co. Remonumentation P.S. #22445" in S Face 15" Walnut N 82° E 23.37'  
PK Nail & Tag Stamped "Oakland Co. Remonumentation P.S. #25854" in NE Face 8" Twin Elm S 47° E 17.72'  
PK Nail & Tag Stamped "Oakland Co. Remonumentation P.S. #25854" in S Face 18" Walnut N 57° W 26.82'  
PK Nail & Tag Stamped "Oakland Co. Remonumentation P.S. #25854" in E Face 6" Ash N 11° W 15.11'

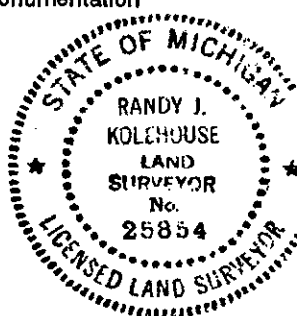

The selected location is accepted by the Contractor and is generally accepted by professional surveyors as the best available evidence of the position of the original corner.

Signed by Randy J. Kolehouse  
EARTH TECH

Date 7/14/95

Surveyor's Michigan License No. 25854