

**SURVEY &  
REMONUMENTATION**

LIBER 14833 PG 135

94 193379

MAY - 1 1995

**LAND CORNER RECORDATION CERTIFICATE**

**COMMISSION Filing Requirement of Act 74, Mich. P.A. 1970**

OK - T. SMITH

For corners in  
Oakland

(County)	Located in:		Corner Code #
	5N	11E	
1. Public Land Survey	T ___ R ___	___	G-2
	T ___ R ___	___	___
	T ___ R ___	___	___
	T ___ R ___	___	___
2. Property Controlling in Section	S ___ T ___ R ___	___	___
	S ___ T ___ R ___	___	___
3. Miscellaneous Property in Sec.	S ___ T ___ R ___	___	___
	S ___ T ___ R ___	___	___
4. Lot No. _____, Recorded Plat _____			
5. Private Claims _____			

\$ 7.00 MISCELLANEOUS RECORDING  
\$ 2.00 REMONUMENTATION  
15 JUL 94 7:30 A.M. RECEIPT# 1A  
PAID RECORDED - OAKLAND COUNTY  
LYNN D. ALLEN, CLERK/REGISTER OF DEEDS  
Compliance with  
ACT 345, P.A. 1990

APPROVED ON: 12-15-93  
OAKLAND COUNTY REMONUMENT  
Register of Deeds, Stamp & File Number  
PER GROUP COMMITTEE

I, Bruce Antcliff, in a field survey on November 9, 1993, do hereby certify that under requirements of P.A. 74, Michigan P.A. of 1970, the corner points mentioned in lines 1 and 2 above were in conformance with regulations and rules therefore as required in the current manual of survey instructions of the United States Department of the Interior, Bureau of Land Management or by a decree of a Court of Law and/or that the corner points mentioned in lines 3, 4 and 5 above were in conformance with the rules of the Michigan Board of Land Surveyors or by a Decree of a Court of Law; established, re-established, monumented, re-monumented, recovered, found as expressed below:

**NOTE: Not more than 4 corners, all in the same town and range, may be recorded on this certificate.**

A. Description of original monument and accessories and/or subsequent restoration:  
G-2 GLO County Witness L.C.R.C. L. 8279, P. 705 (1974)  
Post Iron 1/2" Iron Rod  
WNW - 30.10' 6" Elm East - 19.23' 12" Maple  
NE - 22.0' 24" Elm S 05° W - 43.46' 10" Maple  
East - 25.0' Fence Corner N 85° W - 19.30' 12" Maple

Baldwin Survey B21, P39 (1929)	Survey 87 - 105 A. Smith (1987)
Iron Pipe	1/2" Rerod
24" Elm NE 22.0'	E 19.62' 15" Maple
6" Elm W 30.0'	S 10° W 43.51' 12" Maple

L.C.R.C. L. 8846, P. 262 (1984)  
1/2" Iron Rod on W Edge Haven Road  
S 10° W - 43.50' to N/W, E Face 12" Maple  
East 19.52 to N/W S Face 15" Maple  
N 50° E - 31.39' to N/W, NW 8" Maple  
N 10° W - 92.88' to N/W, E 18" Maple

B. Description of corner evidence found and/or method applied in restoring or reestablishing corner:

G-2 Found 1/2" rebar ± 3' East of west edge of gravel road (Haven Road).  
Checks the following witnesses:

L.C.R.C. L. 6279, P. 705  
East - 19.23' 12" Maple


L.C.R.C. L. 8846, P. 262  
East - 19.52' Nail S Side 15" Maple  
N 10° W - 92.88' Nail E Side 18" Maple

Smith Survey  
E 19.62' 15" Maple

C. Description of monument for corner and accessories established to perpetuate locating the position of the corner:  
G-2 The selected location is accepted by the Contractor and is generally accepted by professional surveyors as the best available evidence of the position of the original corner.

Set 5/8" rebar with standard Oakland County cap.

P.K. Nail and Brass Tag in N Face 16" Maple - East - 19.46'  
P.K. Nail and Brass Tag in SE Face 36" Quad Maple - N 50° E - 58.90'  
P.K. Nail and Brass Tag in E Face 22" Maple - N 10° W - 92.88'  
P.K. Nail and Brass Tag in E Face 10" Maple - S 05° E - 93.89'

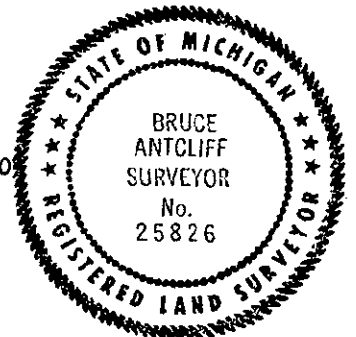

Signed by Bruce Antcliff  
25826

Date 7-11-94

Surveyor's Michigan License No. \_\_\_\_\_