

**SURVEY &  
REMONUMENTATION**

94 193376

MAY - 1 1995

LIBER 14833 PG 132

**LAND CORNER RECORDATION CERTIFICATE  
COMMISSION Filing Requirement of Act 74, Mich. P.A. 1970**

For corners in  
Oakland


(County)	Located In:	Corner Code #
1. Public Land Survey	T 5N R 11E	G-5
	T _____ R _____	_____
	T _____ R _____	_____
	T _____ R _____	_____
2. Property Controlling in Section	S _____ T _____ R _____	_____
	S _____ T _____ R _____	_____
3. Miscellaneous Property in Sec.	S _____ T _____ R _____	_____
	S _____ T _____ R _____	_____

OK - T. SMITH

\$ 7.00 MISCELLANEOUS RECORDING  
 \$ 2.00 REMONUMENTATION  
 15 JUL 94 7:30 A.M. RECEIPT# 1A  
 PAID RECORDED - OAKLAND COUNTY  
 LYNN D. ALLEN REGISTER OF DEEDS  
ACT 74, P.A. 1970

APPROVED ON: 12-15-93  
 OAKLAND COUNTY REGISTER OF DEEDS  
 PEER GROUP COMMITTEE

4. Lot No. \_\_\_\_\_, Recorded Plat \_\_\_\_\_  
 5. Private Claims \_\_\_\_\_

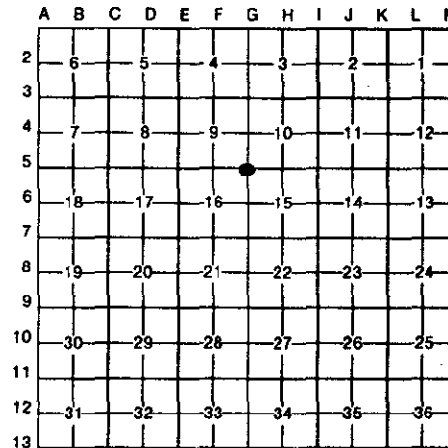

I, Bruce Antcliff, in a field survey on November 8, 1993, do hereby certify that under requirements of P.A. 74, Michigan P.A. of 1970, the corner points mentioned in lines 1 and 2 above were in conformance with regulations and rules therefore as required in the current manual of survey instructions of the United States Department of the Interior, Bureau of Land Management or by a decree of a Court of Law and/or that the corner points mentioned in lines 3, 4 and 5 above were in conformance with the rules of the Michigan Board of Land Surveyors or by a Decree of a Court of Law; established, re-established, monumented, re-monumented, recovered, found as expressed below:

**NOTE: Not more than 4 corners, all in the same town and range, may be recorded on this certificate.**

**A. Description of original monument and accessories and/or subsequent restoration:**

G-5 GLO Post	L.C.R.C. L. 6205, P. 775 (1973) N & T N Side Cor Post at Center Line Az. 73° 16.43	Survey L. 12442, P. 533, Fnd 1/2" Iron S 50° E 16.11' PK N Side 24" Hick. N 40° E 42.29' PK W Side 18" Cherry	L.C.R.C. L. 12868, P. 606 (1991) 1/2 Iron 25' E of Center Line of Noble and Haven Roads S 45° E 16.22' PK N Face 24" Hickory N 20° E 40.69 PK W Face 19" Cherry S 80° E 55.63 Gate Post
County Witnesses Iron Pipe	N & T 18" Hickory Az. 142° 24.77 Road Sign Az 312° 41.28	N 80° W 71.88' PK S Side 18" Hick. S 10° W 33.19' PK W Side 8" Hick.	
15" Elm NW 66.9			
18" Elm NE 55.6			
18" Hickory SE 16.6			

*700  
700  
file*

**B. Description of corner evidence found and/or method applied in restoring or reestablishing corner:**

G-5 Found 1/2" rebar 0.1' SW of 1" iron pipe 25' E of center line Noble and Haven Road intersection. Checks the following witnesses:


County Witnesses	L.C.R.C. L. 6205, P. 775	Survey L. 12442, P. 533	L.C.R.C. L. 12868, P. 606
18" Hickory SE 16.6'	Nail & Tag N Side Corner Fence Post Az. 73° 16.43'	S 50° E 16.11' PK N. Side 24" Hick.	S 45° E 16.22' PK North Face 24" Hick.

**C. Description of monument for corner and accessories established to perpetuate locating the position of the corner:**

G-5 The selected location is accepted by the Contractor and is generally accepted by professional surveyors as the best available evidence of the position of the original corner.

Set 5/8" rebar with standard Oakland County cap.

- P.K. Nail and Brass Tag in S Face 14" Hickory - S 85° E - 39.46'
- P.K. Nail and Brass Tag in N Face 20" Hickory - S 35° E - 16.60'
- P.K. Nail and Brass Tag in S. Face 16" Hickory - N 76° W - 71.82'
- P.K. Nail and Brass Tag in W. Face 12" Hickory - S 15° W - 33.26'

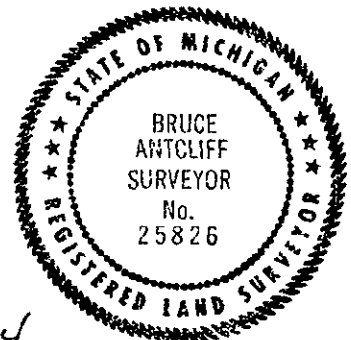

Signed by Bruce Antcliff Date 7-11-94  
 Surveyor's Michigan License No. 25826