

**SURVEY &
REMONUMENTATION**

MAY - 1 1995

LIBER **14833** PG **111**

94 193355
OK - T. SMITH

COMMISSION LAND CORNER RECORDATION CERTIFICATE
Filing Requirement of Act 74, Mich. P.A. 1970

For corners in
Oakland

(County)

Located In:

Corner Code **##**


		5N	11E	H-5
1. Public Land Survey	T	_____	R	_____
	T	_____	R	_____
	T	_____	R	_____
	T	_____	R	_____
2. Property Controlling in Section	S	_____	T	_____
	S	_____	T	_____
3. Miscellaneous Property in Sec.	S	_____	T	_____
	S	_____	T	_____

\$ 7.00 MISCELLANEOUS RECORDING
\$ 2.00 REMONUMENTATION
15 JUL 94 7:26 A.M. RECEIPT# 1A
PAID RECORDED - OAKLAND COUNTY
LYNN D. ALLEN, CLERK/REGISTER OF DEEDS

Compliance with
ACT 345, P.A. 1990

APPROVED ON: 11-94 2-2-94
OAKLAND COUNTY REMONUMENTATION
PEER GROUP COMMITTEE
Register of Deeds Stamp & File Number

4. Lot No. _____, Recorded Plat _____
5. Private Claims _____

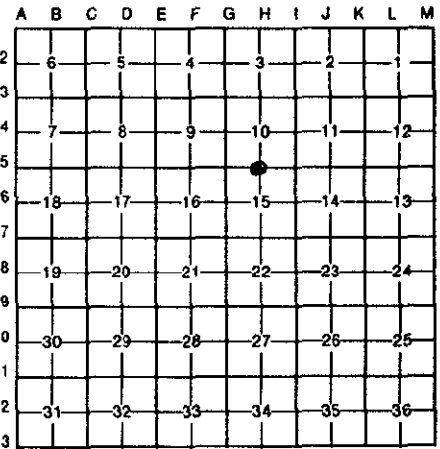

Bruce Antcliff November 10 93

I, _____, in a field survey on _____, 19 _____, do hereby certify that under requirements of P.A. 74, Michigan P.A. of 1970, the corner points mentioned in lines 1 and 2 above were in conformance with regulations and rules therefore as required in the current manual of survey instructions of the United States Department of the Interior, Bureau of Land Management or by a decree of a Court of Law and/or that the corner points mentioned in lines 3, 4 and 5 above were in conformance with the rules of the Michigan Board of Land Surveyors or by a Decree of a Court of Law; established, re-established, monumented, re-monumented, recovered, found as expressed below:

NOTE: Not more than 4 corners, all in the same town and range, may be recorded on this certificate.

A. Description of original monument and accessories and/or subsequent restoration:

H-5	GLO Post	L.C.R.C. L 6205, P. 789 (1973) 1/2" Iron Rebar N & T W Side 4" Poplar Az. 17° 20.09' N & T E Side 3" T. Alder Az. 145° 9.12' N & T E Side 3" T. Alder Az. 215° 7.07'	Survey L. 12442, P. 533 (1989) 1/2" Iron S 50° W 13.03' Nail 4" Cherry North 14.31' Nail 10" Elm N 70° E 22.62' Nail 15" Cottonwood East 12.65' Nail Twin 6" Ash
		L.C.R.C. L. 7288, P. 544 Same as Above	

*700
300
710*

B. Description of corner evidence found and/or method applied in restoring or reestablishing corner:

H-5 Found 1/2 Iron at the intersection of fences running N - S - E & W.
Checks the following Witness from Survey L. 12442, P. 533.


S 50° W 13.03' Nail 4" Cherry
N 70° E 22.62' Nail 15" Cottonwood
East 12.65' Nail Twin 6" Ash

C. Description of monument for corner and accessories established to perpetuate locating the position of the corner:

H-5 The selected location is accepted by the Contractor and is generally accepted by professional surveyors as the best available evidence of the position of the original corner.

Set concrete monument with standard Oakland County cap.

P.K. Nail and Brass Tag in N Face 12" Poplar - N 80° E - 22.73'
P.K. Nail and Brass Tag in NW Face 6" Poplar - N 50° E - 21.75'
P.K. Nail and Brass Tag in NE Face 8" Poplar - N 50° W - 21.76'
P.K. Nail and Brass Tag in SE Face 6" Cherry - S 70° W - 12.95'
1/2" Iron is at Intersection of Fences N-S-E & W

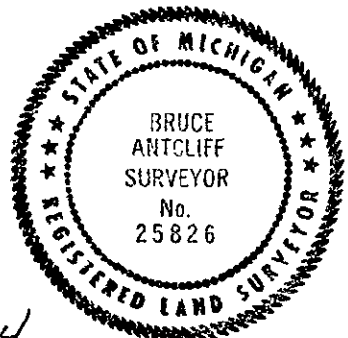

Signed by Bruce Antcliff
Surveyor's Michigan License No. 25826

Date 2-11-94