

SURVEY & REMONUMENTATION

LIBER **14833** PG **112**

94 **193356**

MAY - 1 1995

LAND CORNER RECORDATION CERTIFICATE
Filing Requirement of Act 74, Mich. P.A. 1970

OK - T. SMITH

For corners in Oakland

COMMISSION

(County)	Located In:	Corner Code #
1. Public Land Survey	5N 11E T ___ R ___ T ___ R ___ T ___ R ___ T ___ R ___	I-1
2. Property Controlling in Section	S ___ T ___ R ___ S ___ T ___ R ___	
3. Miscellaneous Property in Sec.	S ___ T ___ R ___ S ___ T ___ R ___	

\$ 7.00 MISCELLANEOUS RECORDING
\$ 2.00 REMONUMENTATION
15 JUL 94 7:26 A.M. RECEIPT# 1A
PAID RECORDED - OAKLAND COUNTY
LYNN D. ALLEN, CLERK/REGISTER OF DEEDS
Compliance with ACT 345, P.A. 1990

APPROVED ON: 12-22-93
OAKLAND COUNTY REMONUMENTATION
PEER GROUP COMMITTEE
Register of Deeds Stamp & File Number

4. Lot No. _____, Recorded Plat _____
5. Private Claims _____

A	B	C	D	E	F	G	H	I	J	K	L	M
2	6	5	4	3	2	1						
3												
4	7	8	9	10	11	12						
5												
6	16	17	16	15	14	13						
7												
8	19	20	21	22	23	24						
9												
10	30	29	28	27	26	25						
11												
12	31	32	33	34	35	36						
13												

Bruce Antcliff, in a field survey on **November 8**, 19**93**, do hereby certify that under requirements of P.A. 74, Michigan P.A. of 1970, the corner points mentioned in lines 1 and 2 above were in conformance with regulations and rules therefore as required in the current manual of survey instructions of the United States Department of the Interior, Bureau of Land Management or by a decree of a Court of Law and/or that the corner points mentioned in lines 3, 4 and 5 above were in conformance with the rules of the Michigan Board of Land Surveyors or by a Decree of a Court of Law; established, re-established, monumented, re-monumented, recovered, found as expressed below:

NOTE: Not more than 4 corners, all in the same town and range, may be recorded on this certificate.

A. Description of original monument and accessories and/or subsequent restoration:

I-1	GLO	L.C.R.C. L. 6196, P. 458 (1972)	L.C.R.C. L. 004, P. 188 (1989)	Survey L. 11792, P. 231
	Post	3/4" Iron pipe	Fnd 1/2" Pipe at W Edge Rochester Rd	Same as L.C.R.C. L. 004, P. 188 (1989)
		N 88° W - 28.13' Nail N Side 36" Oak	Lapeer County (I-13)	
		N 44° W - 44.00' Nail SW Side 24" Oak	PK in 20" Oak N NE 100.51'	
		N 30° E - 53.66' Nail W Side 18" Maple	PK in 12" Pine NW 35.43'	
		W Edge of Rochester Rd East 1'	PK in 10" Elm W NW 33.12'	
			PK in 7" Ash W SW 37.05'	

Handwritten signature/initials

B. Description of corner evidence found and/or method applied in restoring or reestablishing corner:

I-1	Found 3/4" iron pipe ± 0.7' W of West edge of Bit Road (Rochester Road) and intersection of Bordman Road.		
	Checks the following witnesses:		
	L.C.R.C. L. 6196, P. 458 (1972)	L.C.R.C. L. 004, P. 188 (1989)	Survey L. 11792, P. 231
	W Edge of Rochester Rd East 1'	PK in 20" Oak N NE 100.51'	Same as L.C.R.C. L. 004, P. 188 (1989)
		PK in 7" Ash W SW 37.05'	


Per the G.L.O. notes this corner is common with the SW corner Section 35, T6N, R11W, Lapeer County.

C. Description of monument for corner and accessories established to perpetuate locating the position of the corner:

I-1 The selected location is accepted by the Contractor and is generally accepted by professional surveyors as the best available evidence of the position of the original corner.

Set 5/8" rebar with standard Oakland County cap.

- P.K. Nail and Brass Tag in SE Face 20" Oak - N 35° E - 100.93'
- P.K. Nail and Brass Tag in S. Face 34" Oak - N 80° E - 100.00'
- P.K. Nail and Brass Tag in E Face Power Pole - N 10° W - 59.85'
- P.K. Nail and Brass Tag in SE Face 10" Ash - S 70° W - 37.10'

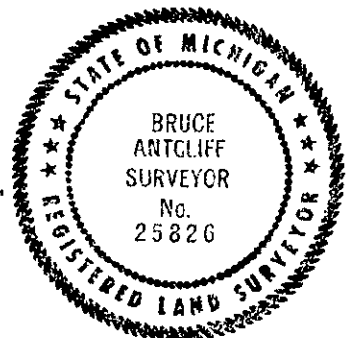

Signed by Bruce Antcliff
25826

Date 7-11-94

Surveyor's Michigan License No. _____