

**SURVEY &
REMONUMENTATION**

MAY - 1 1995

LIBER 14833 PG 114

94 193358

**LAND CORNER RECORDATION CERTIFICATE
COMMISSION Filing Requirement of Act 74, Mich. P.A. 1970**

OK - T. SMITH

For corners in
Oakland

(County)	Located In:	Corner Code #
	5N 11E	I-3
1. Public Land Survey	T ___ R ___	_____
	T ___ R ___	_____
	T ___ R ___	_____
	T ___ R ___	_____
2. Property Controlling in Section	S ___ T ___ R ___	_____
	S ___ T ___ R ___	_____
3. Miscellaneous Property in Sec.	S ___ T ___ R ___	_____
	S ___ T ___ R ___	_____

\$ 7.00 MISCELLANEOUS RECORDING
\$ 2.00 REMONUMENTATION
15 JUL 94 7:27 A.M. RECEIPT# 1A
PAID
RECORDED IN OAKLAND COUNTY
LYNN D. ALLEN, CLERK/REGISTER OF DEEDS
APPROVED ON: 12-22-93
OAKLAND COUNTY REMONUMENTATION
PEER GROUP COMMITTEE

Register of Deeds Stamp & File Number

4. Lot No. _____, Recorded Plat _____
5. Private Claims _____

Bruce Antcliff November 12 93

I, _____, in a field survey on _____, 19 _____, do hereby certify that under requirements of P.A. 74, Michigan P.A. of 1970, the corner points mentioned in lines 1 and 2 above were in conformance with regulations and rules therefore as required in the current manual of survey instructions of the United States Department of the Interior, Bureau of Land Management or by a decree of a Court of Law and/or that the corner points mentioned in lines 3, 4 and 5 above were in conformance with the rules of the Michigan Board of Land Surveyors or by a Decree of a Court of Law; established, re-established, monumented, re-monumented, recovered, found as expressed below:

NOTE: Not more than 4 corners, all in the same town and range, may be recorded on this certificate.

	A	B	C	D	E	F	G	H	I	J	K	L	M
2	6	5	4	3	2	1							
3													
4	7	8	9	10	11	12							
5													
6	18	17	16	15	14	13							
7													
8	19	20	21	22	23	24							
9													
10	30	29	28	27	26	25							
11													
12	31	32	33	34	35	36							
13													

A. Description of original monument and accessories and/or subsequent restoration:

I-3	GLO Post	L.C.R.C. L. 5881, P. 839 (1972) iron rod S 45° E - 45.37' P.K. Nail P. Pole S 35° W - 95.85' P.K. Nail P. Pole S 85° W - 32.80' P.K. Nail P. Pole	L.C.R.C. L. 8306, P. 662 (1982) 3/4" steel pipe NE - 53.00' SW Corner House No. 5008 WSW - 80.10' NE Corner House No. 4959 SE - 49.53' Nail & O.C.R.C. Cap 21" Maple
-----	----------	---	--

B. Description of corner evidence found and/or method applied in restoring or reestablishing corner:

I-2 Found 1" iron bar in Monument Box at intersection of Rochester Road and Gerit Road.
Checks the following witnesses:


L.C.R.C. L. 5881, P. 839 S 45° E 45.37 P. Pole	L.C.R.C. 8306, P. 662 NE - 53.00' SW Corner House #5008 WSW - 80.10' NE Corner House No. 4959
---	---

C. Description of monument for corner and accessories established to perpetuate locating the position of the corner:

I-3 The selected location of a corner, although not established by an original government survey, is accepted as the best available evidence of the position of the corner.

Set 5/8" rebar with standard Oakland County cap in existing monument box.

NE Corner House #4959 - S 83° W - 80.28'
SW Corner House # 5008 - N 70° E - 53.07'
P.K. Nail and Brass Tag in SW Face Utility Pole - S 45° E - 45.41'
P.K. Nail and Brass Tag in S Face P. Pole - N 87° W - 31.47'

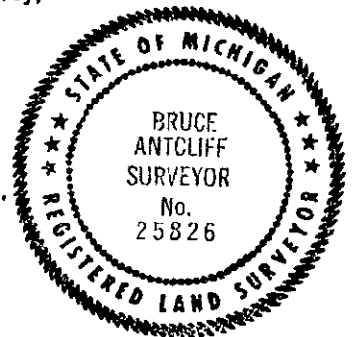

Signed by Bruce Antcliff
25826

Date 7-11-94

Surveyor's Michigan License No. _____