

**SURVEY &
REMONUMENTATION**

LIBER 14833 PG 115

MAY - 1 1995

94 193359

**LAND CORNER RECORDATION CERTIFICATE
COMMISSION Filing Requirement of Act 74, Mich. P.A. 1970**


For corners in
Oakland

OK - T. SMITH

(County)	Located In:	Corner Code #
	5N 11E	I-4
1. Public Land Survey	T ___ R ___	_____
	T ___ R ___	_____
	T ___ R ___	_____
	T ___ R ___	_____
2. Property Controlling in Section	S ___ T ___ R ___	_____
	S ___ T ___ R ___	_____
3. Miscellaneous Property in Sec.	S ___ T ___ R ___	_____
	S ___ T ___ R ___	_____
4. Lot No. _____, Recorded Plat _____		
5. Private Claims _____		

\$ 7.00 MISCELLANEOUS RECORDING
\$ 2.00 REMONUMENTATION
15 JUL 94 7:27 A.M. RECEIPT# 1A
PAID RECORDED - OAKLAND COUNTY
LYNN D. ALLEN, CLERK/REGISTER OF DEEDS
Compliance with
ACT 345, P.A. 1990

APPROVED ON: 12-22-95
OAKLAND COUNTY REMONUMENTATION
Register of Deeds, Stamp & File Number

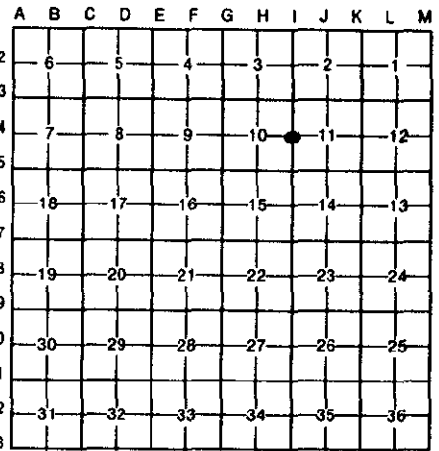

Bruce Antcliff November 11 93
I, _____, in a field survey on _____, 19_____, do hereby certify that under requirements of P.A. 74, Michigan P.A. of 1970, the corner points mentioned in lines 1 and 2 above were in conformance with regulations and rules therefore as required in the current manual of survey instructions of the United States Department of the Interior, Bureau of Land Management or by a decree of a Court of Law and/or that the corner points mentioned in lines 3, 4 and 5 above were in conformance with the rules of the Michigan Board of Land Surveyors or by a Decree of a Court of Law; established, re-established, monumented, re-monumented, recovered, found as expressed below:

NOTE: Not more than 4 corners, all in the same town and range, may be recorded on this certificate.

A. Description of original monument and accessories and/or subsequent restoration:

I-4	GLO Post	County Witness	L.C.R.C. L. 6409, P. 476 (1973)	Survey: Thomas Smith 9/21/87
		NW - 49.6' SE Corner Hotel	1" Iron Bar	Fnd 1" Iron Bar
		NE - 50.5' SW Corner Drug Store	N 46° E - 36.50' Nail W Side P. Pole	S 20° E - 81.54' 8" Oak
		SW - 54.7' NE Corner Garage	S 45° W - 37.10' Nail E Side P. Pole	S 30° W - 55.75' P. Pole
			N 44° W - 49.5' Edge Brick Building	N 45° E - 52.76'

B. Description of corner evidence found and/or method applied in restoring or reestablishing corner:

I-4 Reset 3/4" iron pipe in monument box at centerline intersection of Leonard and Rochester Roads. Checks the following witnesses:


NW 49.6' SE Corner Hotel	L.C.R.C. L. 6409, P. 476	Survey: Thomas Smith 9/21/87
	S 45° W - 37.10' Nail E Side P. Pole	S 20° E - 81.54' 8" Oak
	N 44° W - 49.5 Edge Brick Bldg.	S 30° W - 55.75' P. Pole
		N 45° E - 52.76'

C. Description of monument for corner and accessories established to perpetuate locating the position of the corner:

I-4 The selected location is accepted by the Contractor and is generally accepted by professional surveyors as the best available evidence of the position of the original corner.

Set 5/8" rebar with standard Oakland County cap in existing monument box.

- SE Building Corner to Party Store - N 40° W - 49.34'
- P.K. Nail and Brass Tag in SE Face P. Pole - S 50° W - 36.80'
- P.K. Nail and Brass Tag in SW Face P. Pole - S 21° E - 62.82'
- P.K. Nail and Brass Tag in SE Face P. Pole - N 53° E - 36.26'

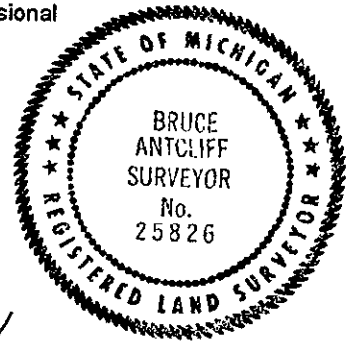

Signed by Bruce Antcliff 25826

Date 7-11-94

Surveyor's Michigan License No. _____